


TOTAL SF AVAILABLE - 40,550 SF


OFFICE - 2,521 SF

WAREHOUSE SF - 38,029 SF

[Click to access 3D model](#)

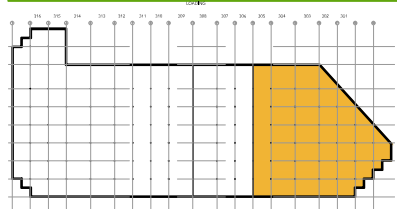

Key Plan

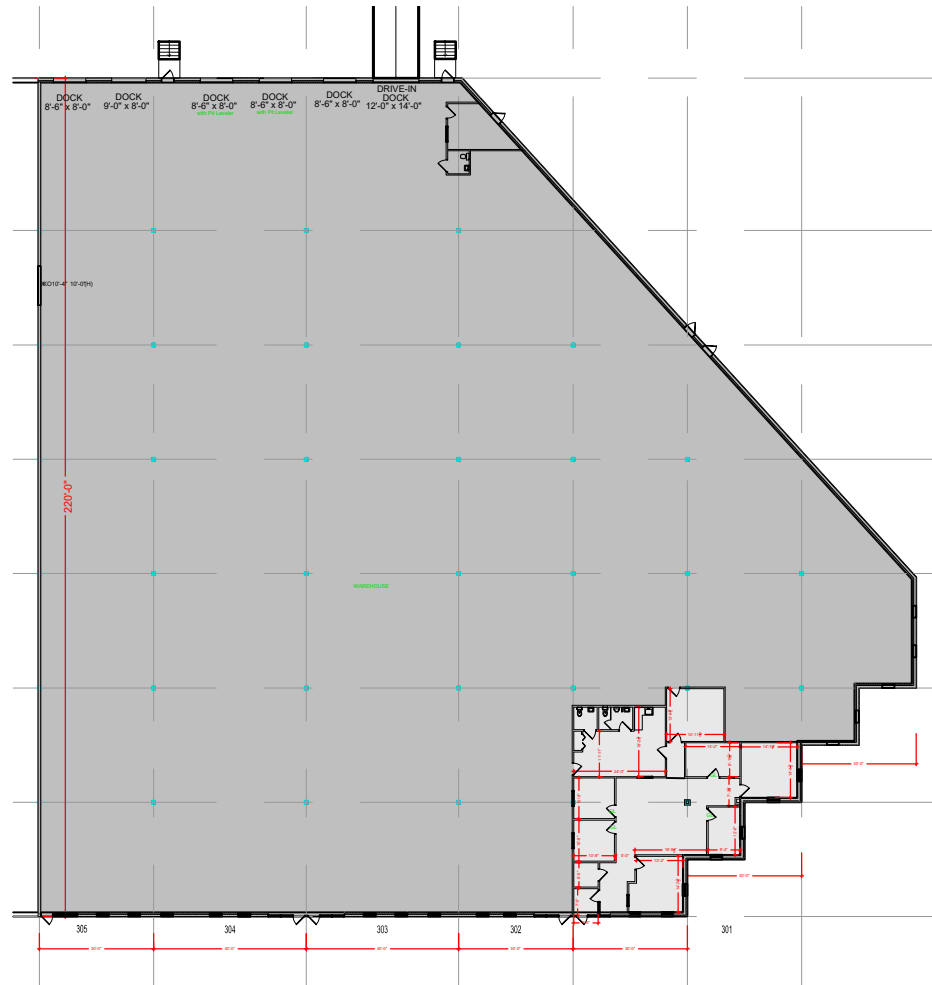

Floor Plan