



TOTAL SF AVAILABLE - 2,301 RSF(16%)

[Click to access 3D model](#)

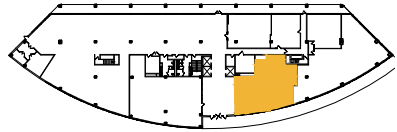

Key Plan

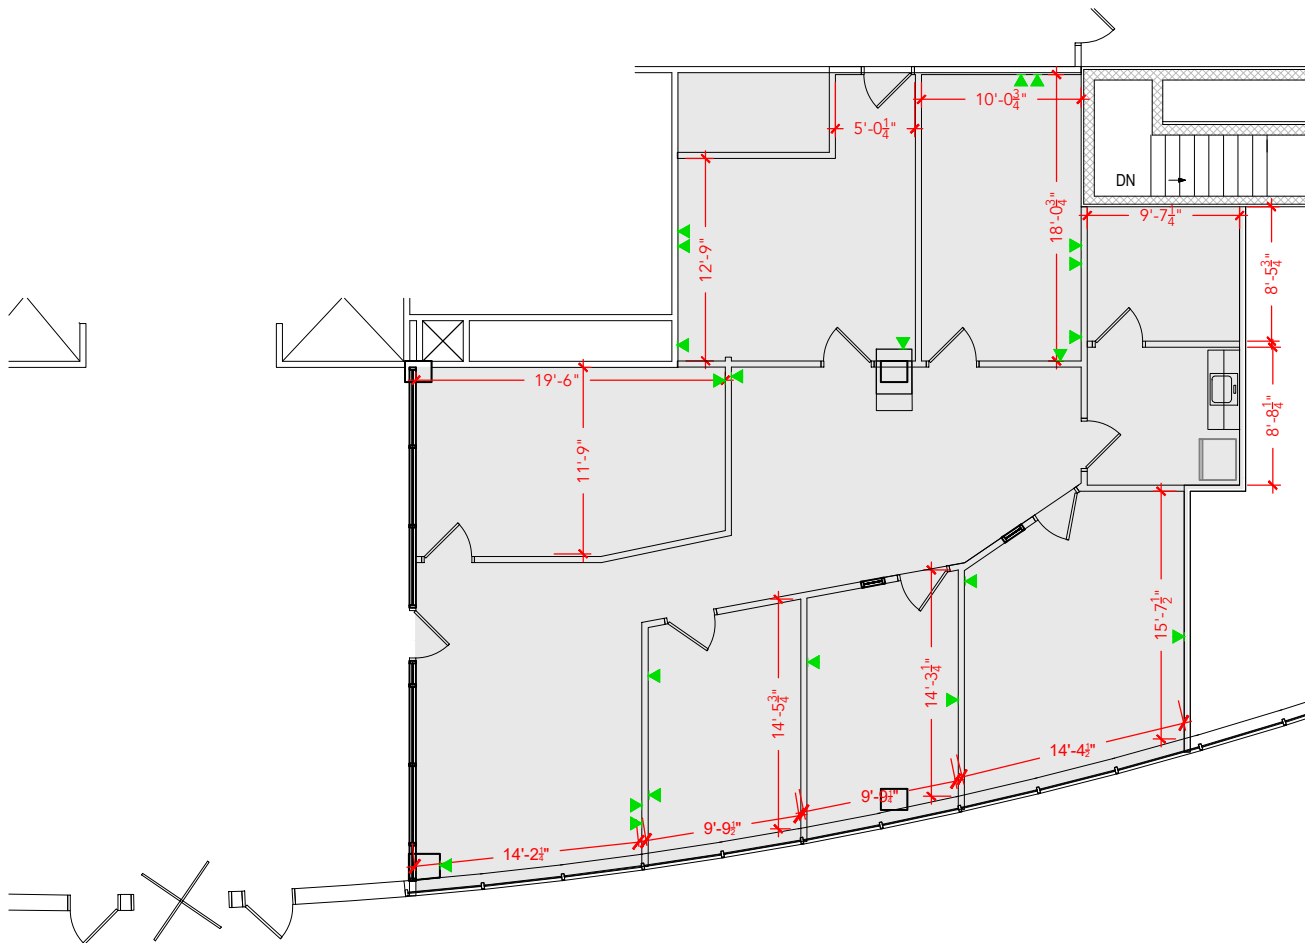

Floor Plan