

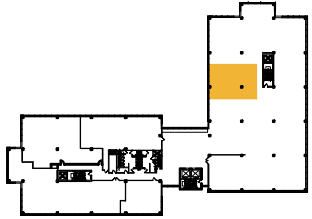


TOTAL SF AVAILABLE - 1,479 RSF(16%)

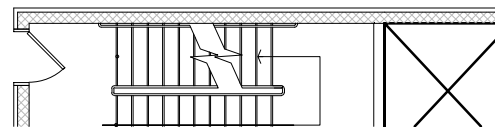

Key Plan

[Click to access 3D model](#)

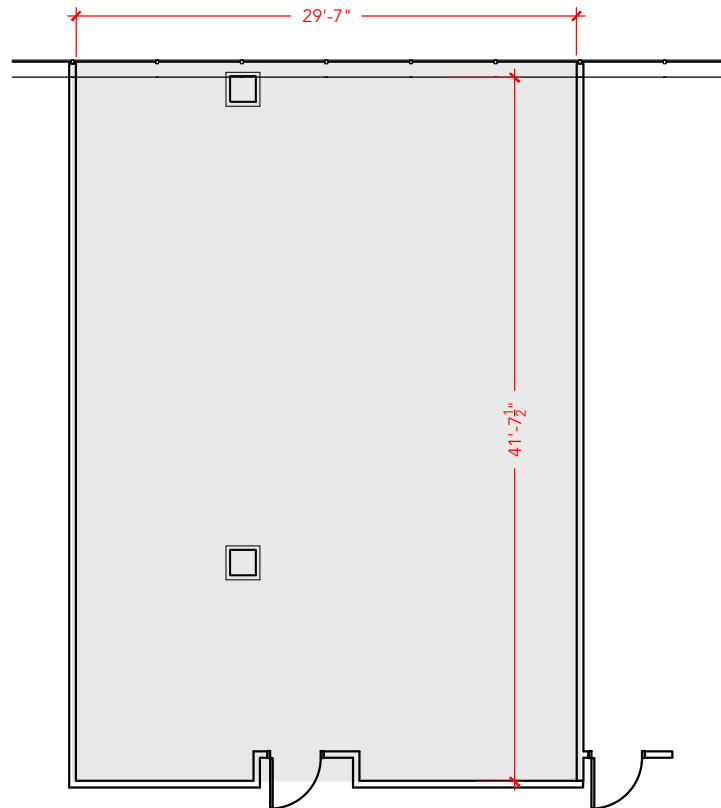

Floor Plan