



TOTAL SF AVAILABLE - 2,579 RSF (16%)

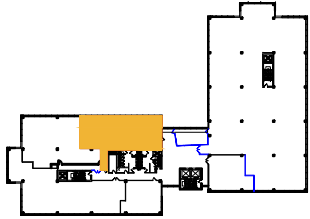

Key Plan

[Click to access 3D model](#)

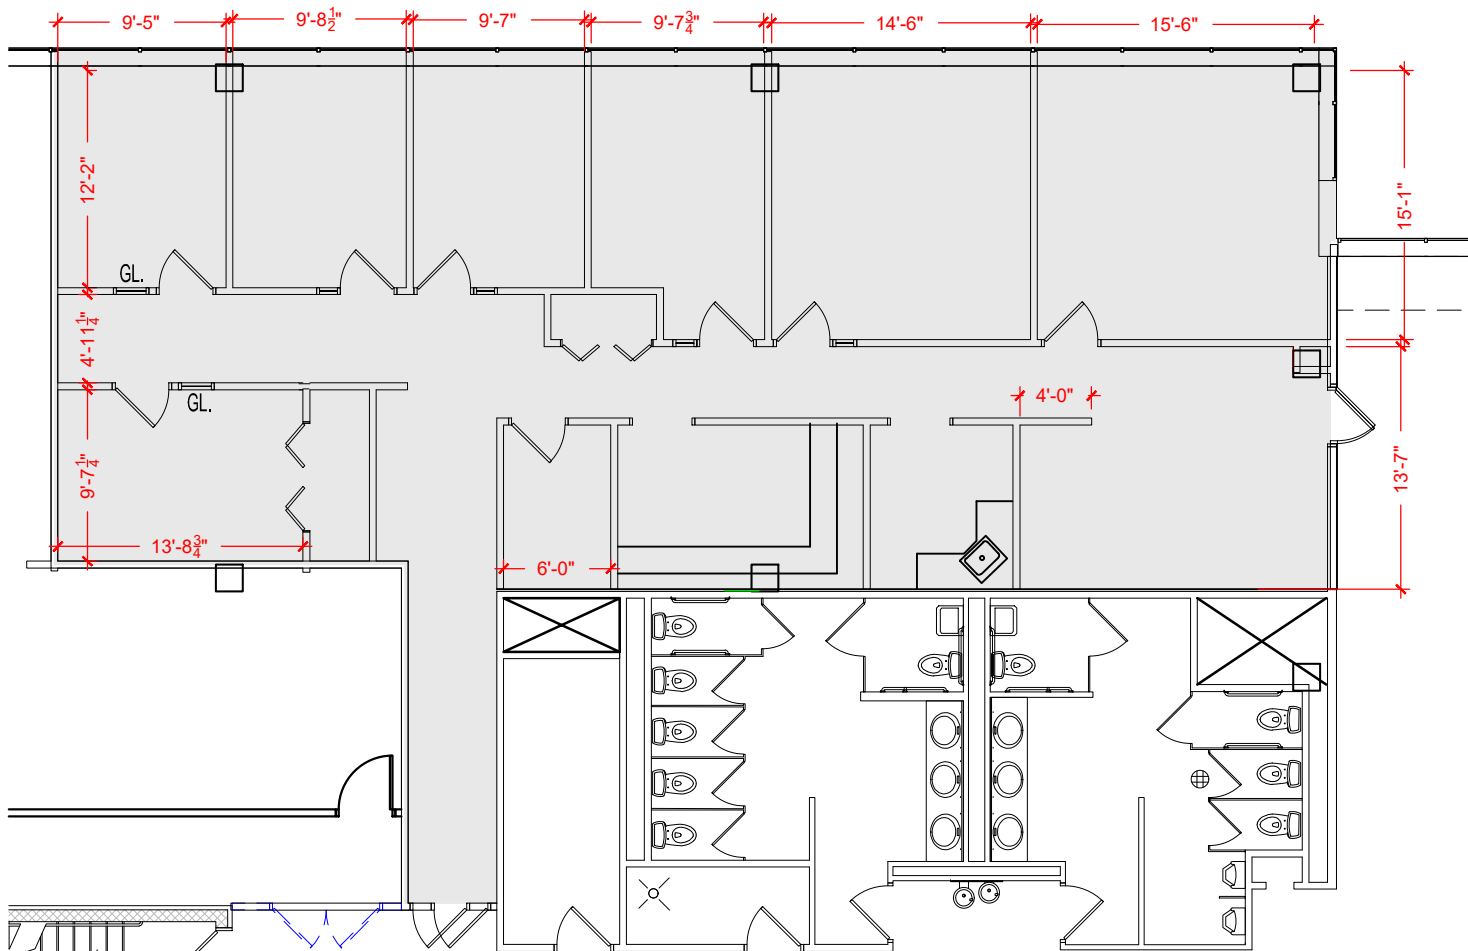

Floor Plan