


TOTAL SF AVAILABLE - 3,636 RSF


OFFICE - 780 RSF

WAREHOUSE - 2,856 RSF

[Click to access 3D model](#)

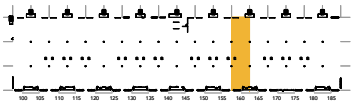

Key Plan

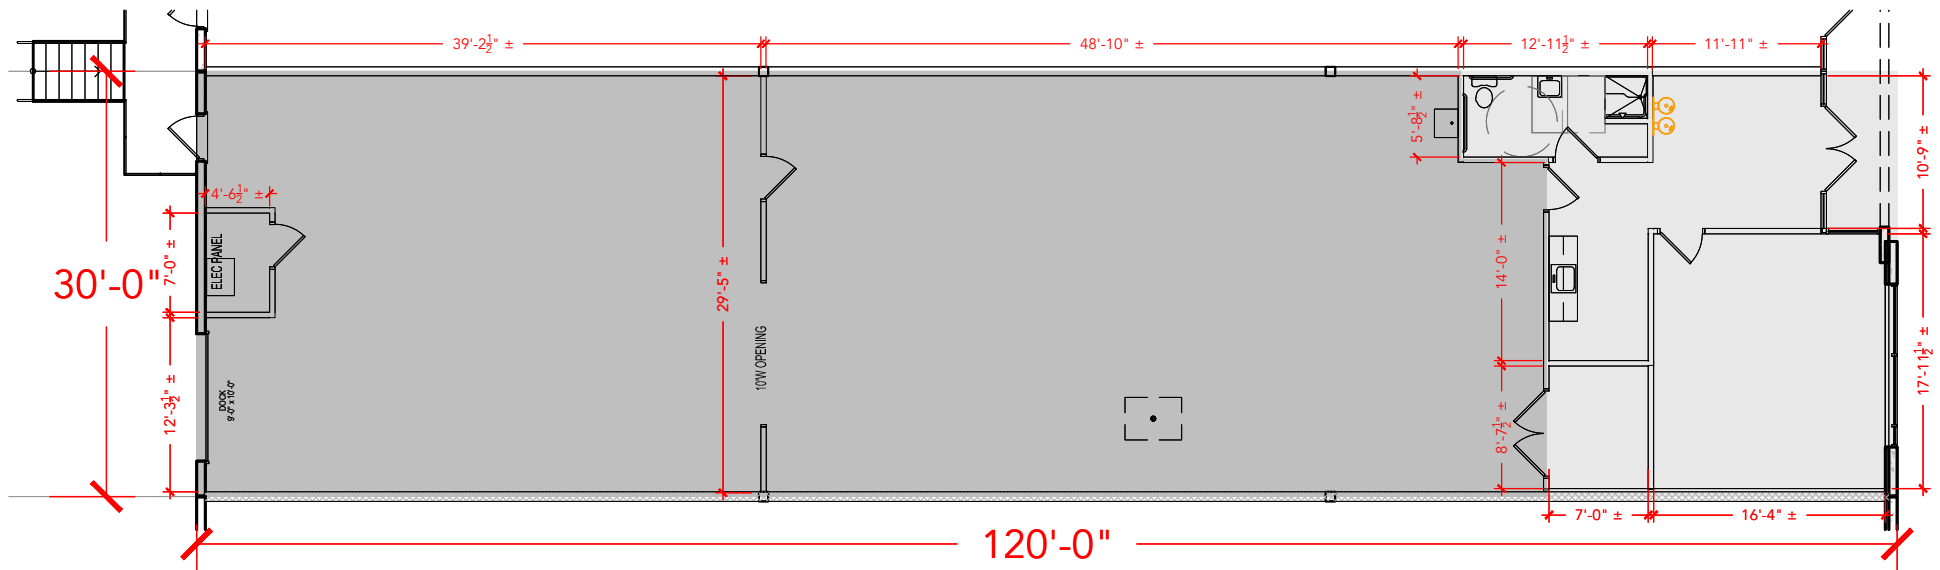

Floor Plan