

Key Plan


TOTAL SF AVAILABLE -28,060 RSF

OFFICE - 10,931 RSF

WAREHOUSE - 17,129 RSF

* INCLUDES % OF METER ROOM

[Click to access 3D model](#)

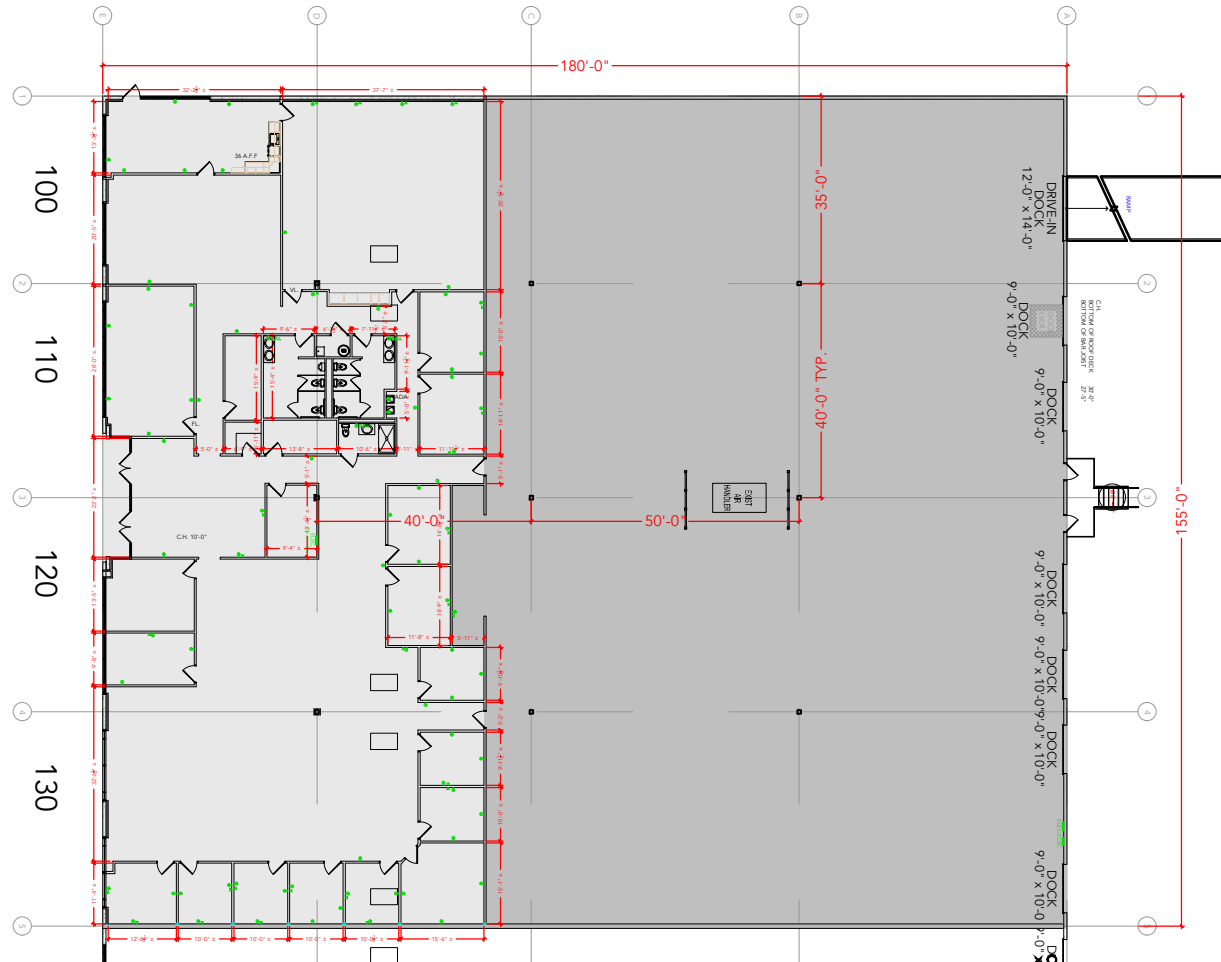

Floor Plan