


TOTAL SF AVAILABLE - 14,897 SF

OFFICE - 4,169 SF


WAREHOUSE SF - 10,729 SF

[Click to access 3D model](#)

2,780 SF MEZZANINE NOT INCLUDED IN TOTALS

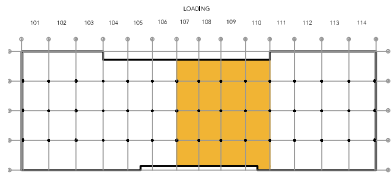


Key Plan

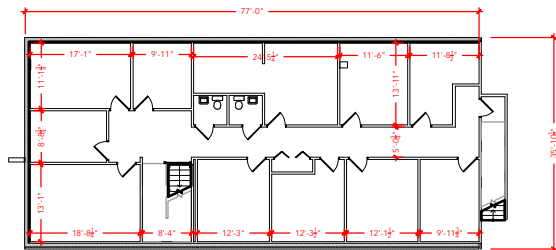

Floor Plan

PLAN NOT TO SCALE - THIS IS NOT A CONSTRUCTION DOCUMENT

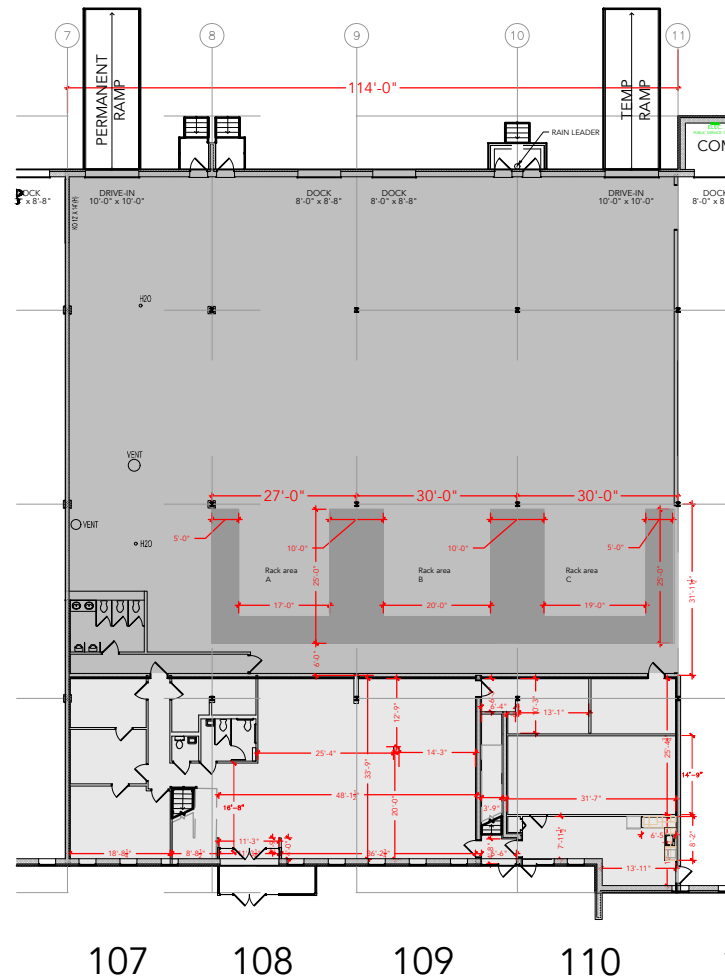

107 108 109 110 1

DRAWING #: BR1-107-110

ASBUILT DATE: **NEEDS TO BE**


TOTAL SF AVAILABLE - 33,748 SF

OFFICE - 5,908 SF



WAREHOUSE SF - 27,840 SF

[Click to access 3D model](#)

2,780 SF MEZZANINE NOT INCLUDED IN TOTALS

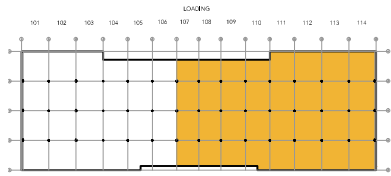

Key Plan

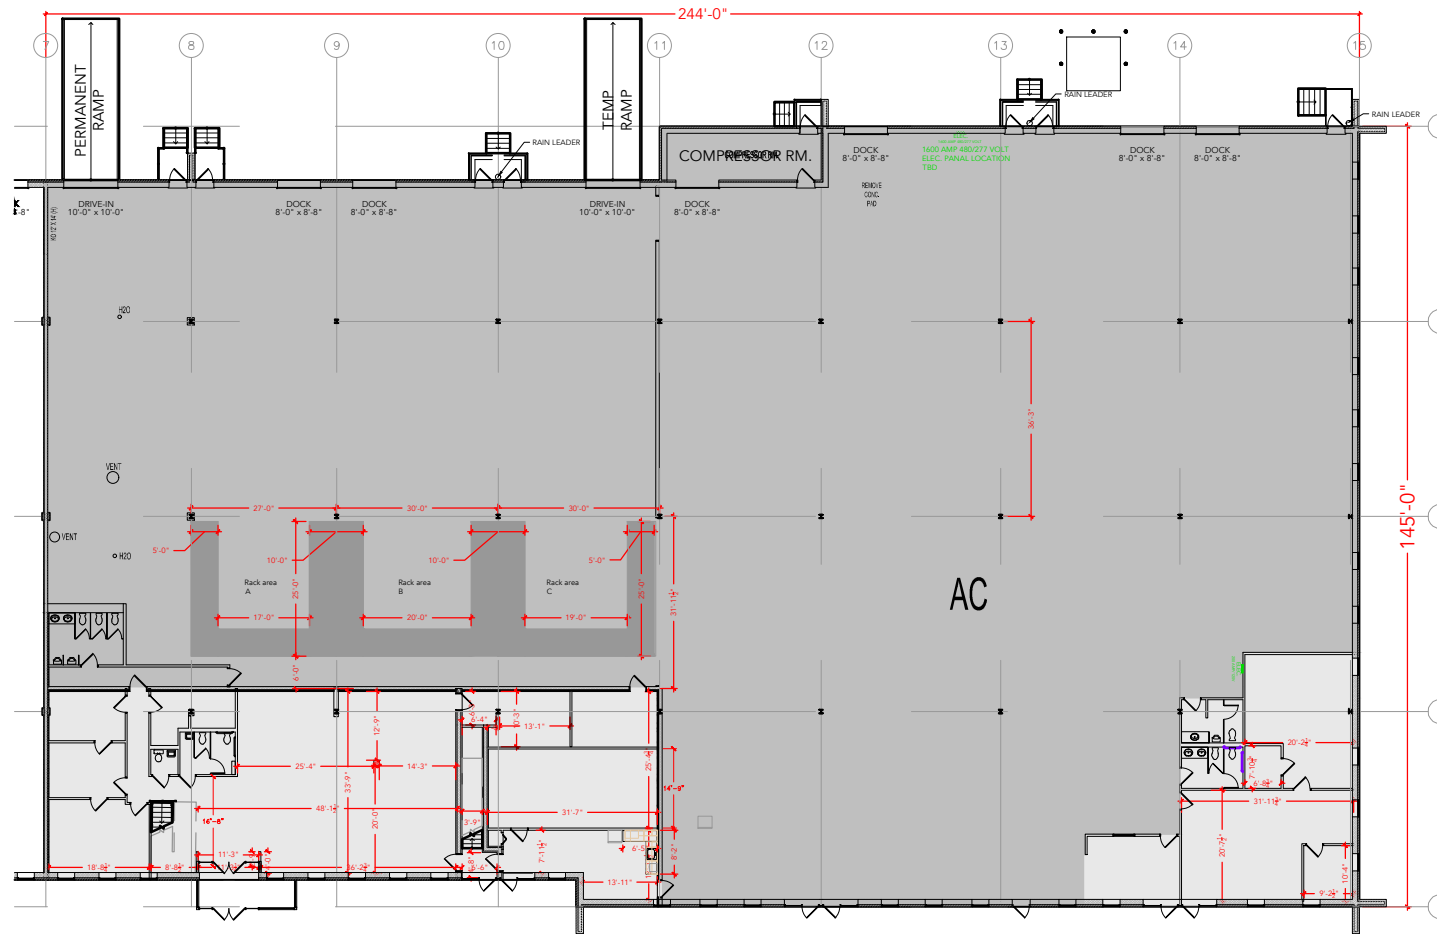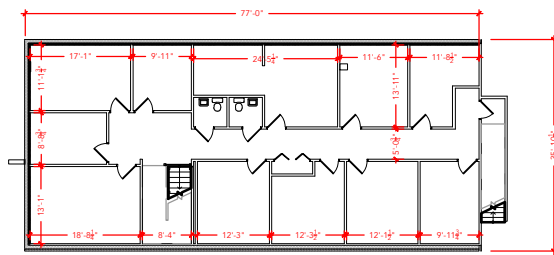

107 108 109 110 111 112 113 114

Floor Plan