


TOTAL SF AVAILABLE - 18,850 SF

OFFICE - 1,719 SF


WAREHOUSE SF - 17,131 SF

[Click to access 3D model](#)

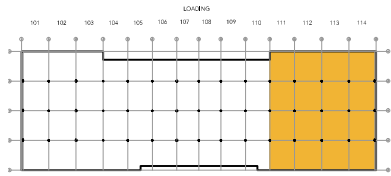

Key Plan

111 112 113 114

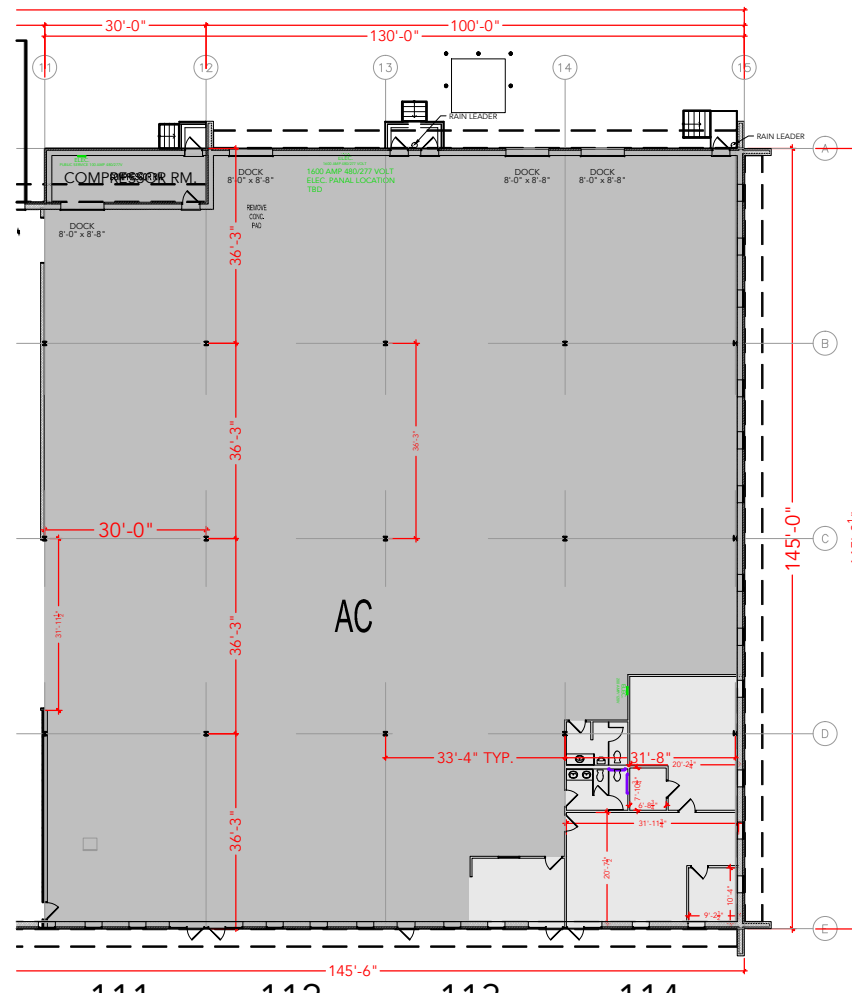


Floor Plan



TOTAL SF AVAILABLE - 33,748 SF

OFFICE - 5,908 SF
WAREHOUSE SF - 27,840 SF

[Click to access 3D model](#)
2,780 SF MEZZANINE NOT INCLUDED IN TOTALS

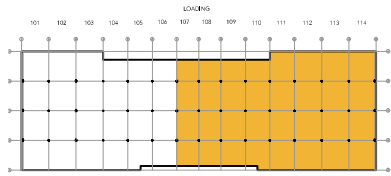

Key Plan

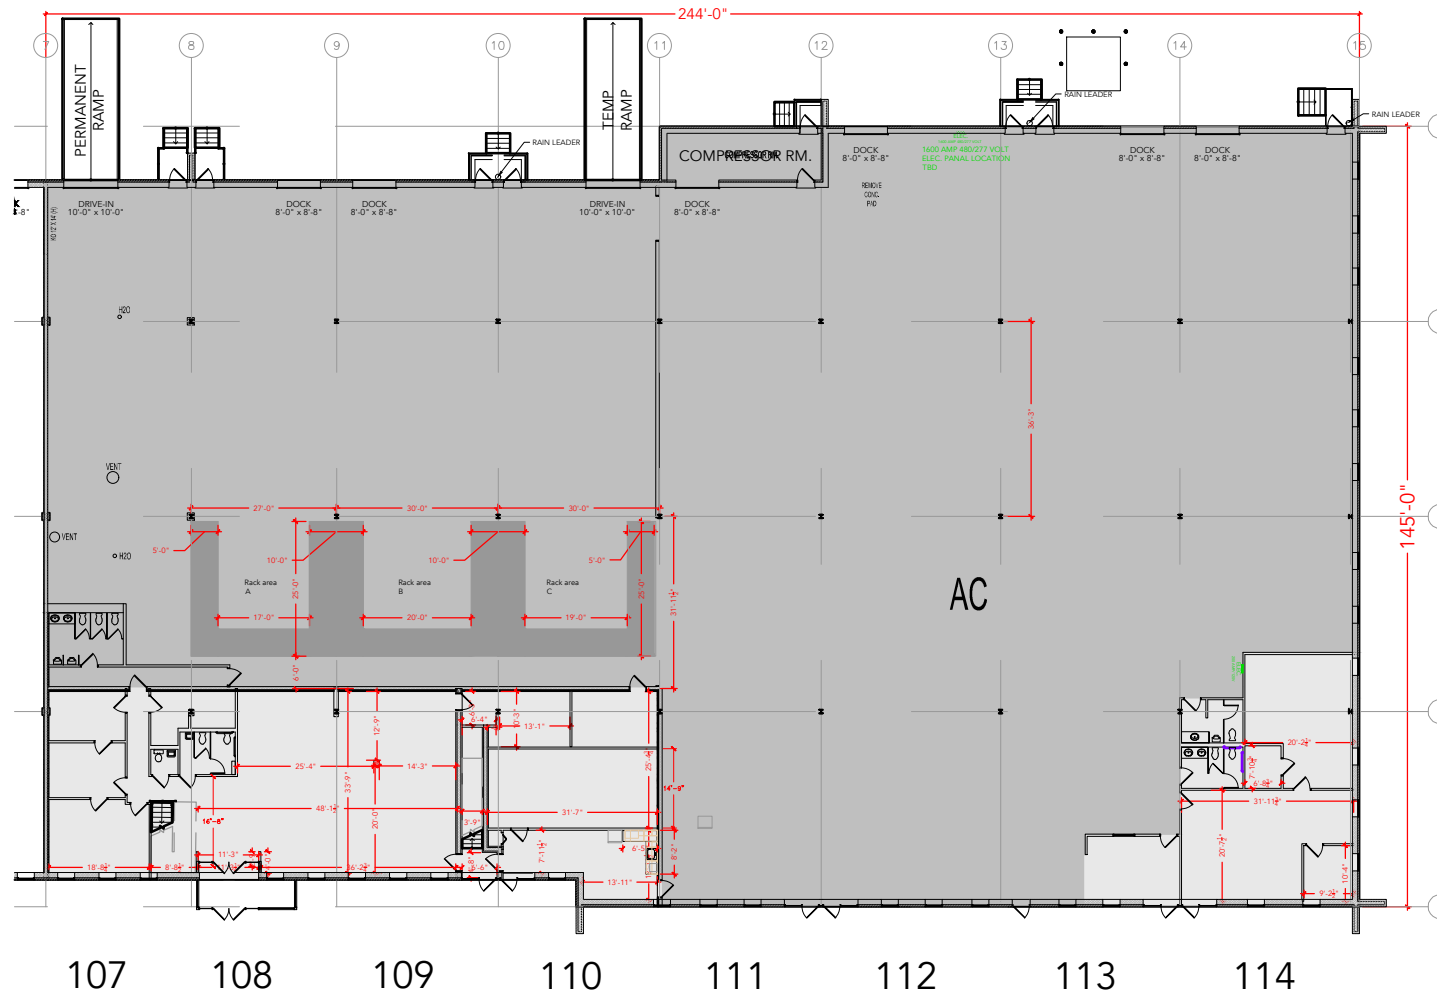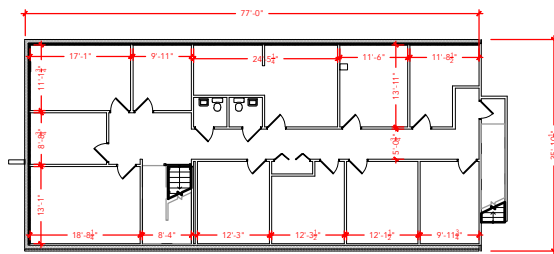

Floor Plan