



TOTAL SF AVAILABLE -22,258 SF

OFFICE - 1,570 SF
WAREHOUSE SF - 20,688 SF

[Click to access 3D model](#)

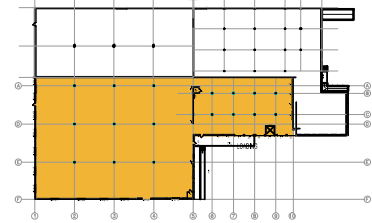

Key Plan

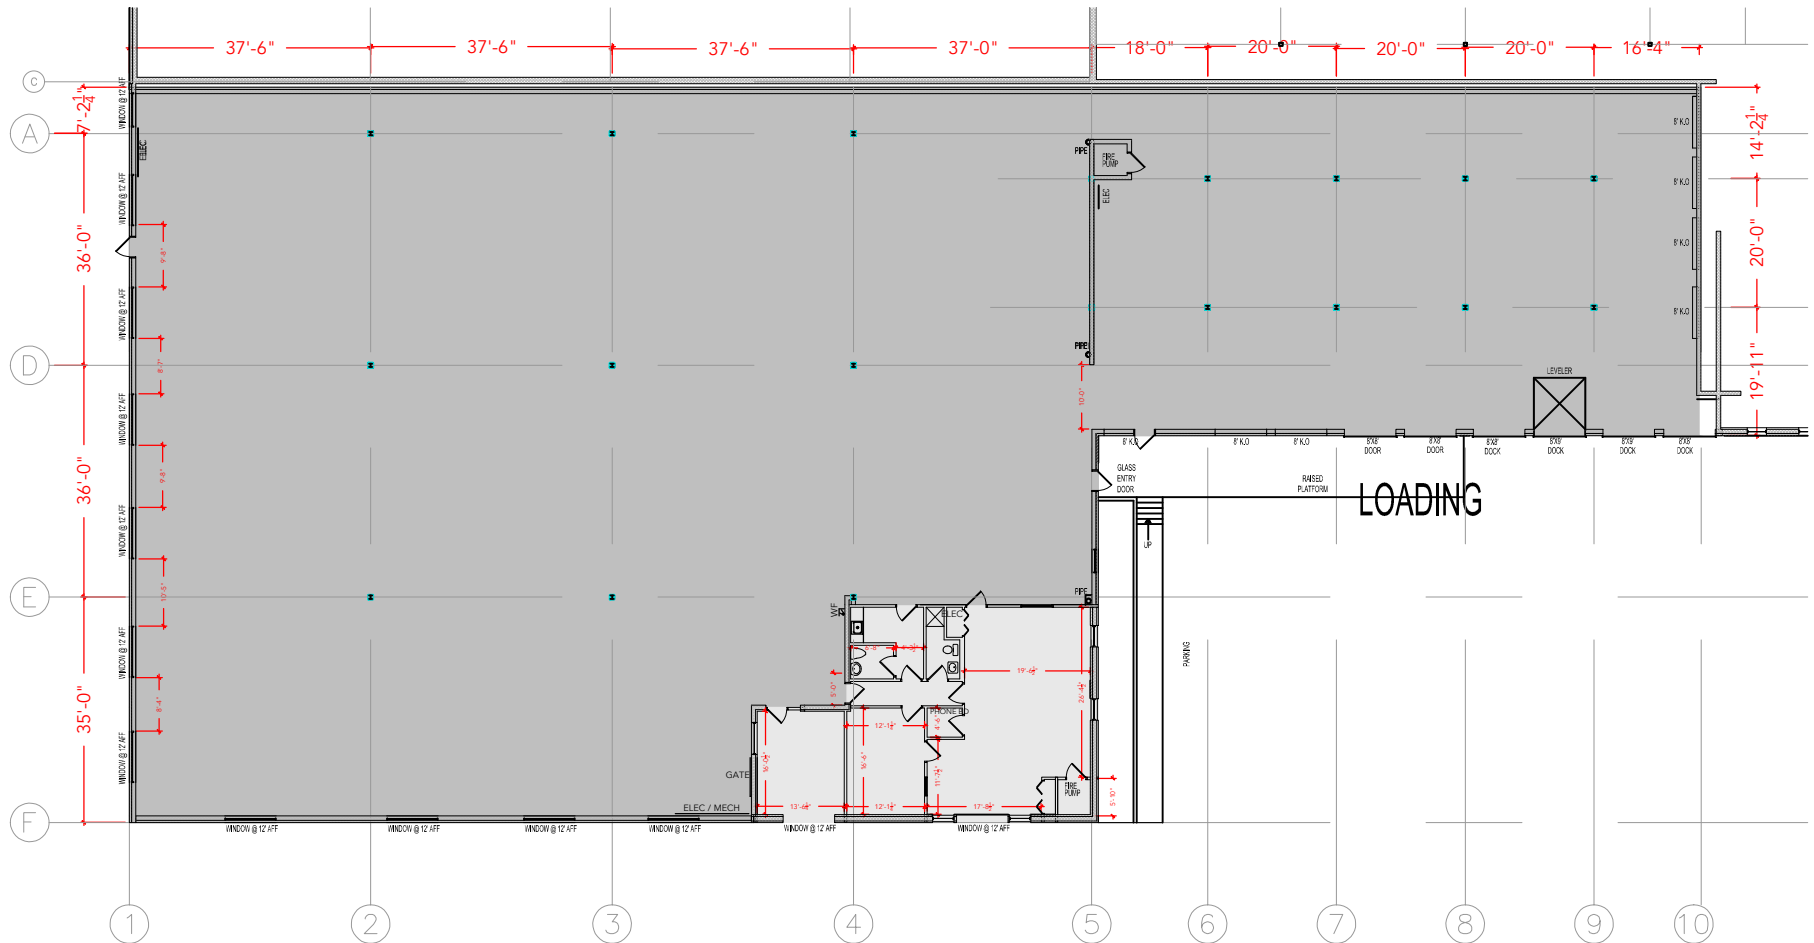

Floor Plan