


TOTAL SF AVAILABLE - 24,000 SF


OFFICE - 5,125 SF

WAREHOUSE - 18,875 SF

[Click to access 3D model](#)

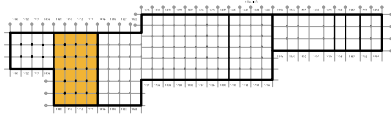

Key Plan

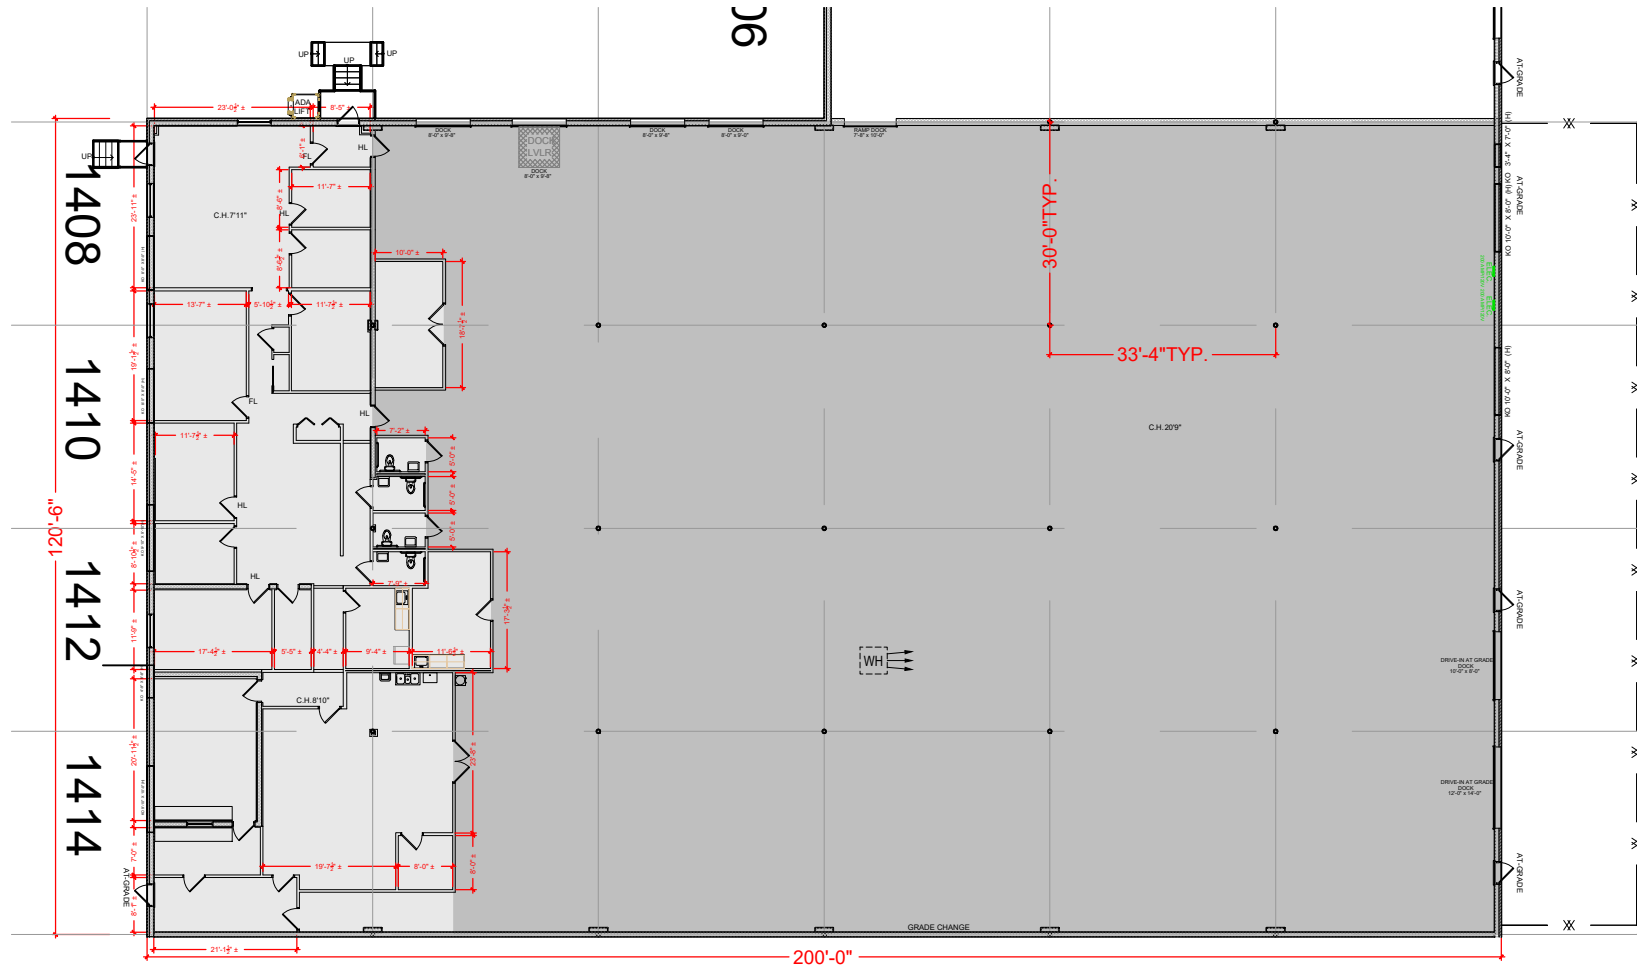

Floor Plan