


TOTAL SF AVAILABLE - 2,376 RSF(12.6%)

[Click to access 3D model](#)

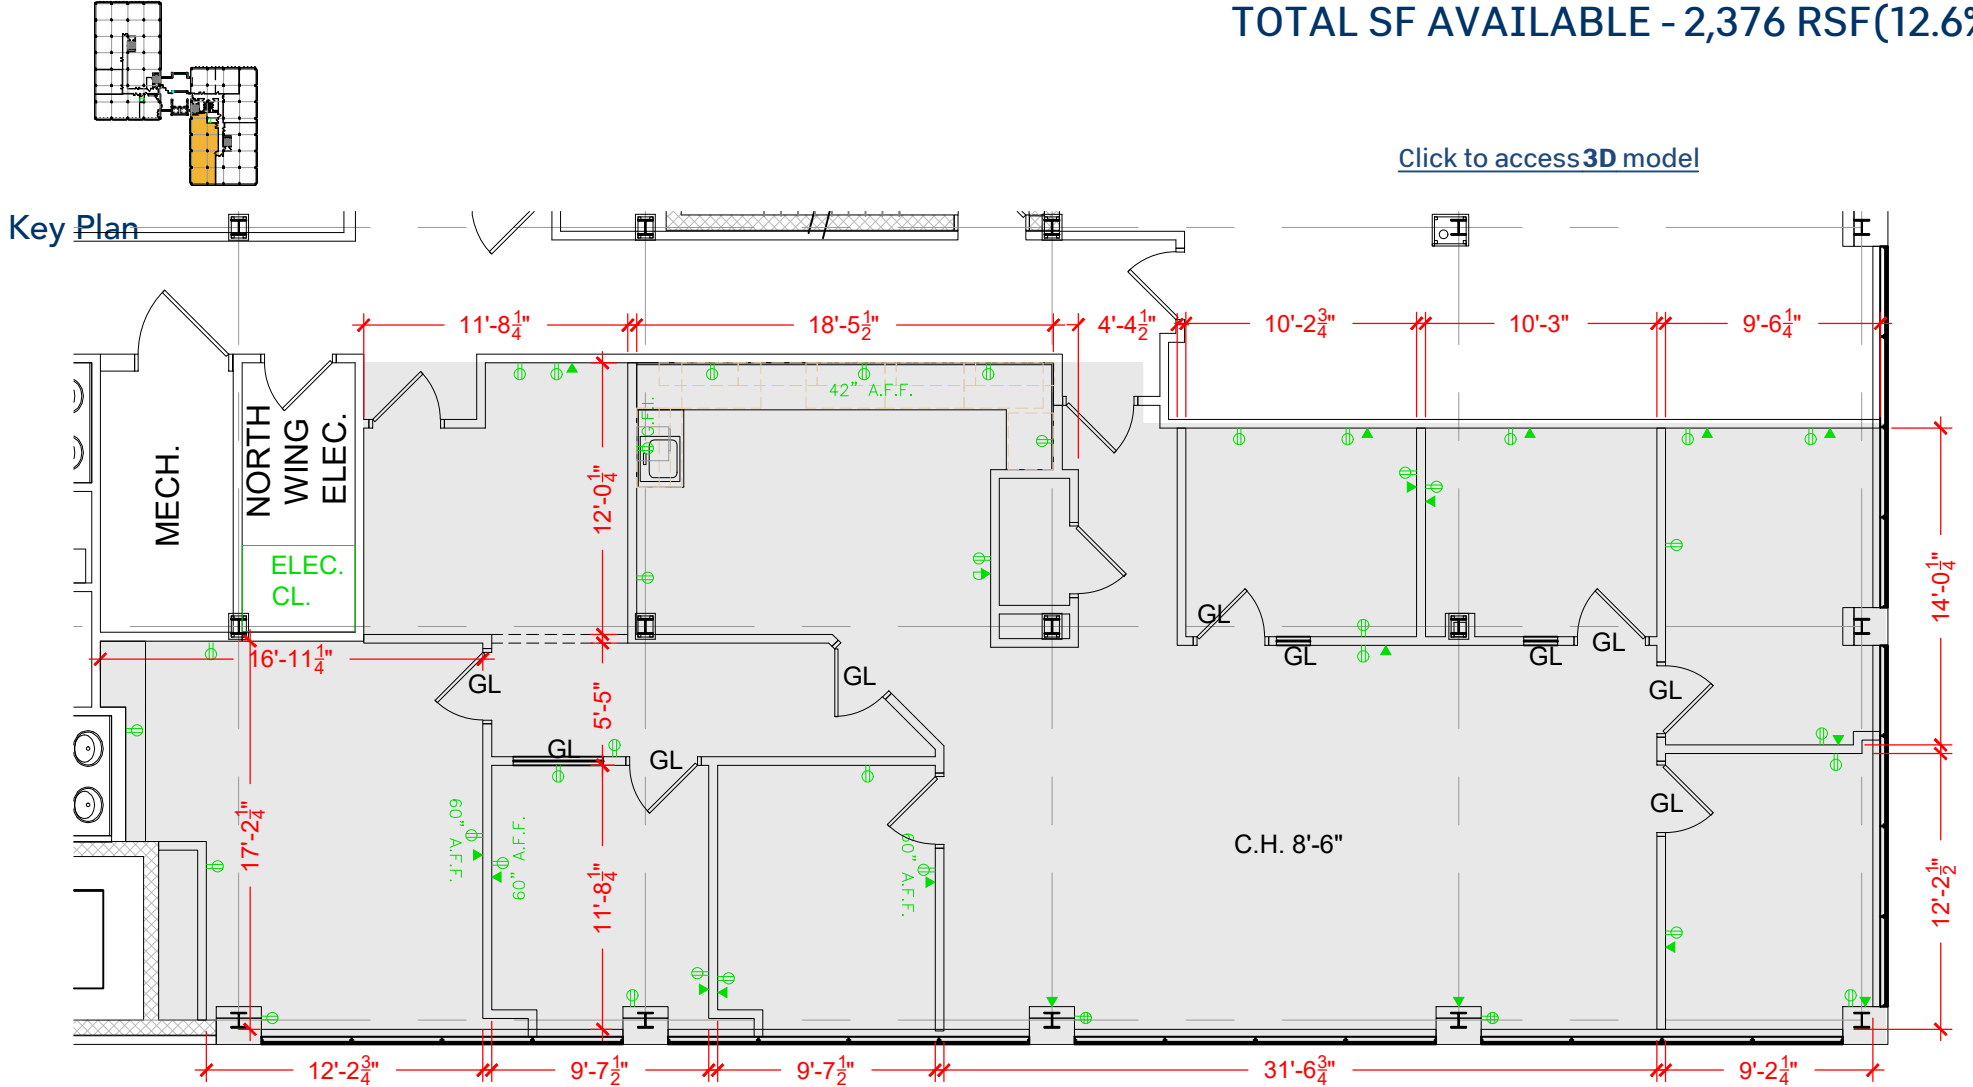

Floor Plan