


**TOTAL SF AVAILABLE - 1,950 SF**

OFFICE - 356 SF


WAREHOUSE - 1,594 SF

[Click to access 3D model](#)

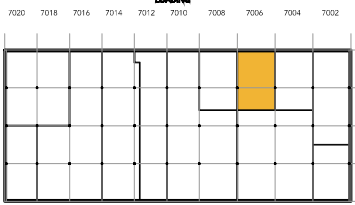

Key Plan

# 7006

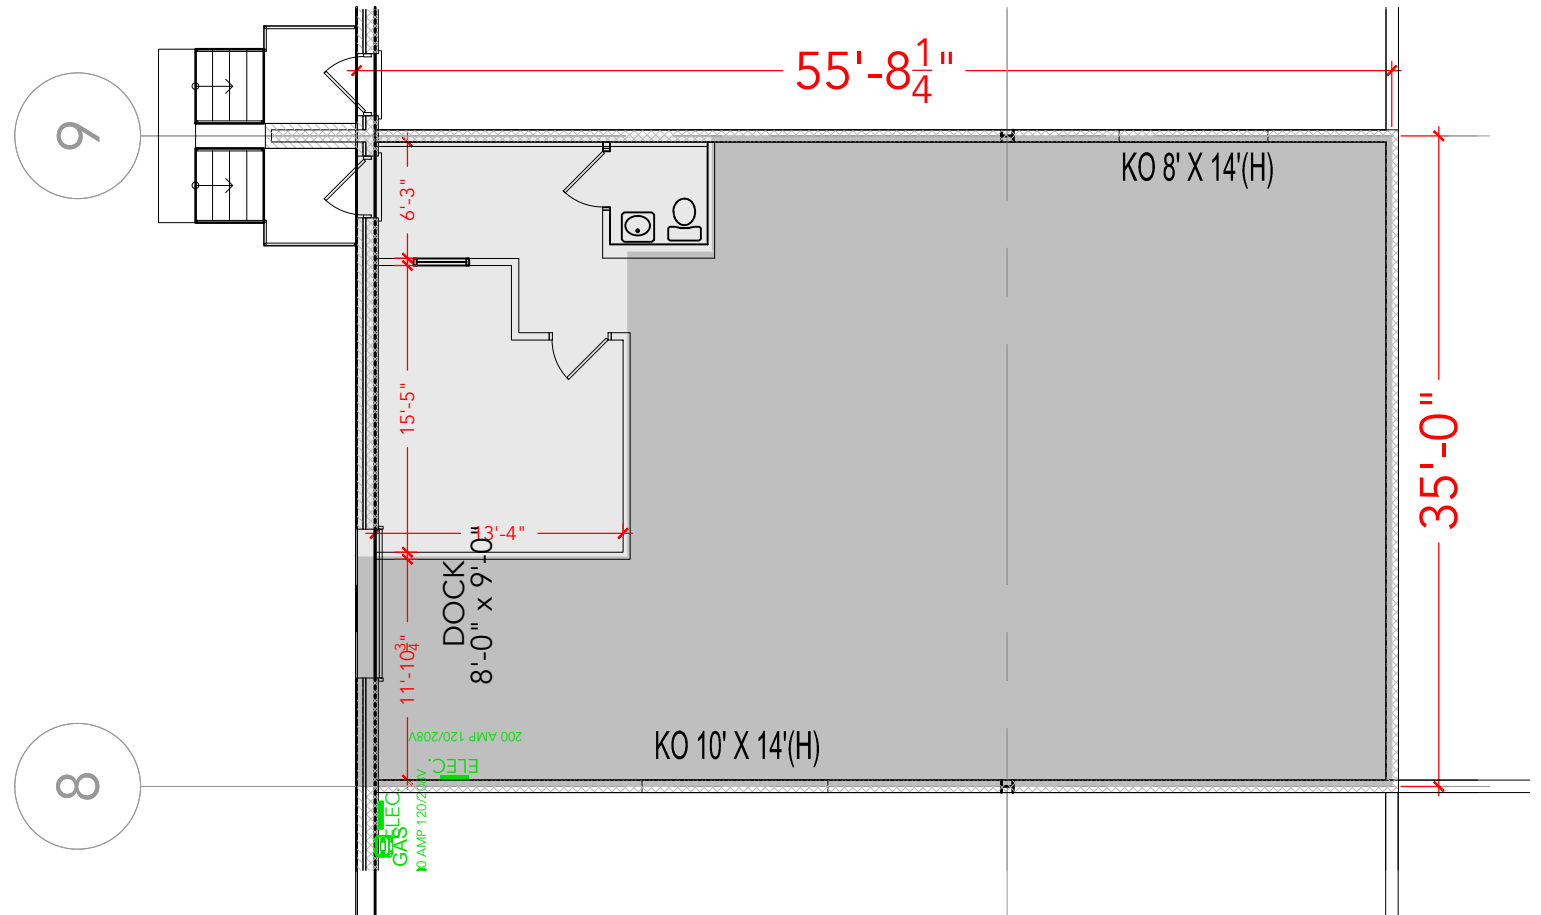

Floor Plan