


TOTAL SF AVAILABLE -3,300 SF


OFFICE - 1,564 SF

WAREHOUSE SF - 1,736 SF

[Click to access 3D model](#)

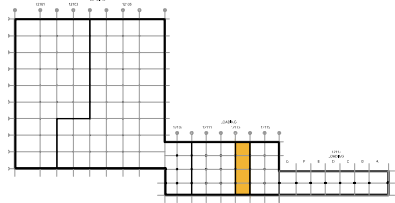

Key Plan

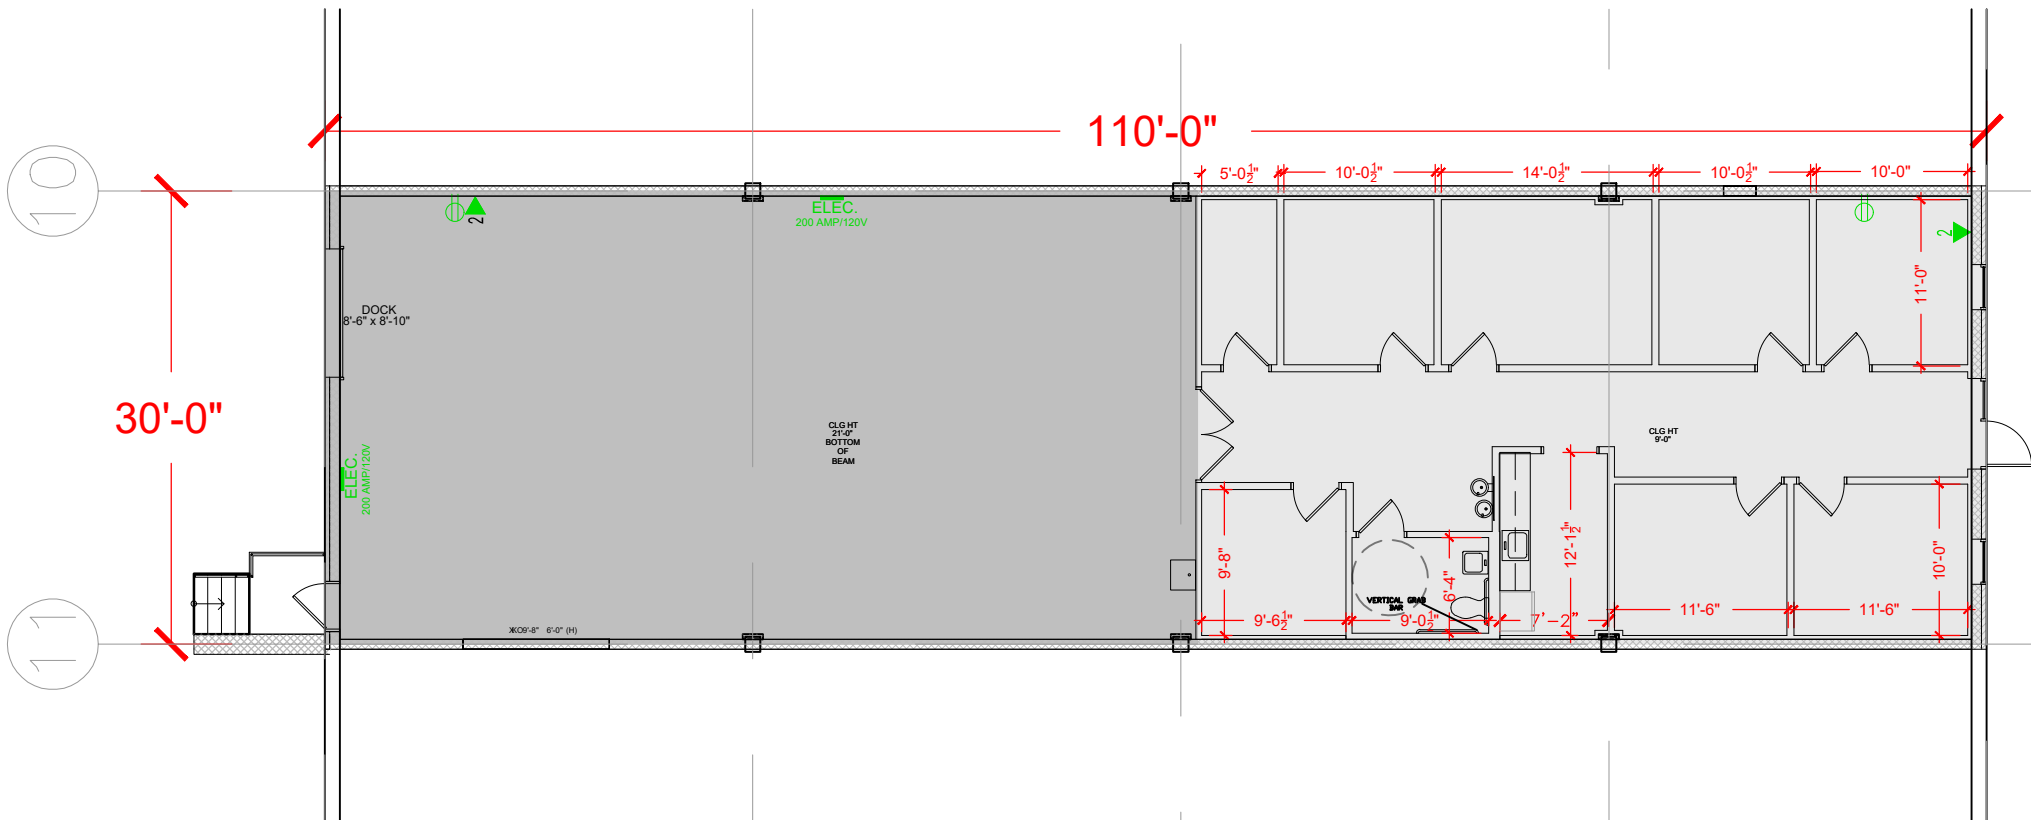

Floor Plan