


**TOTAL SF AVAILABLE -20,000 SF**


**OFFICE - 2,042 SF**

**WAREHOUSE - 17,958 SF**

[Click to access 3D model](#)

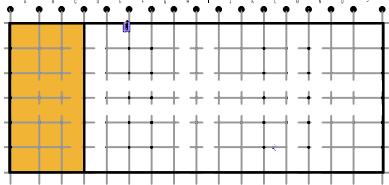

Key Plan

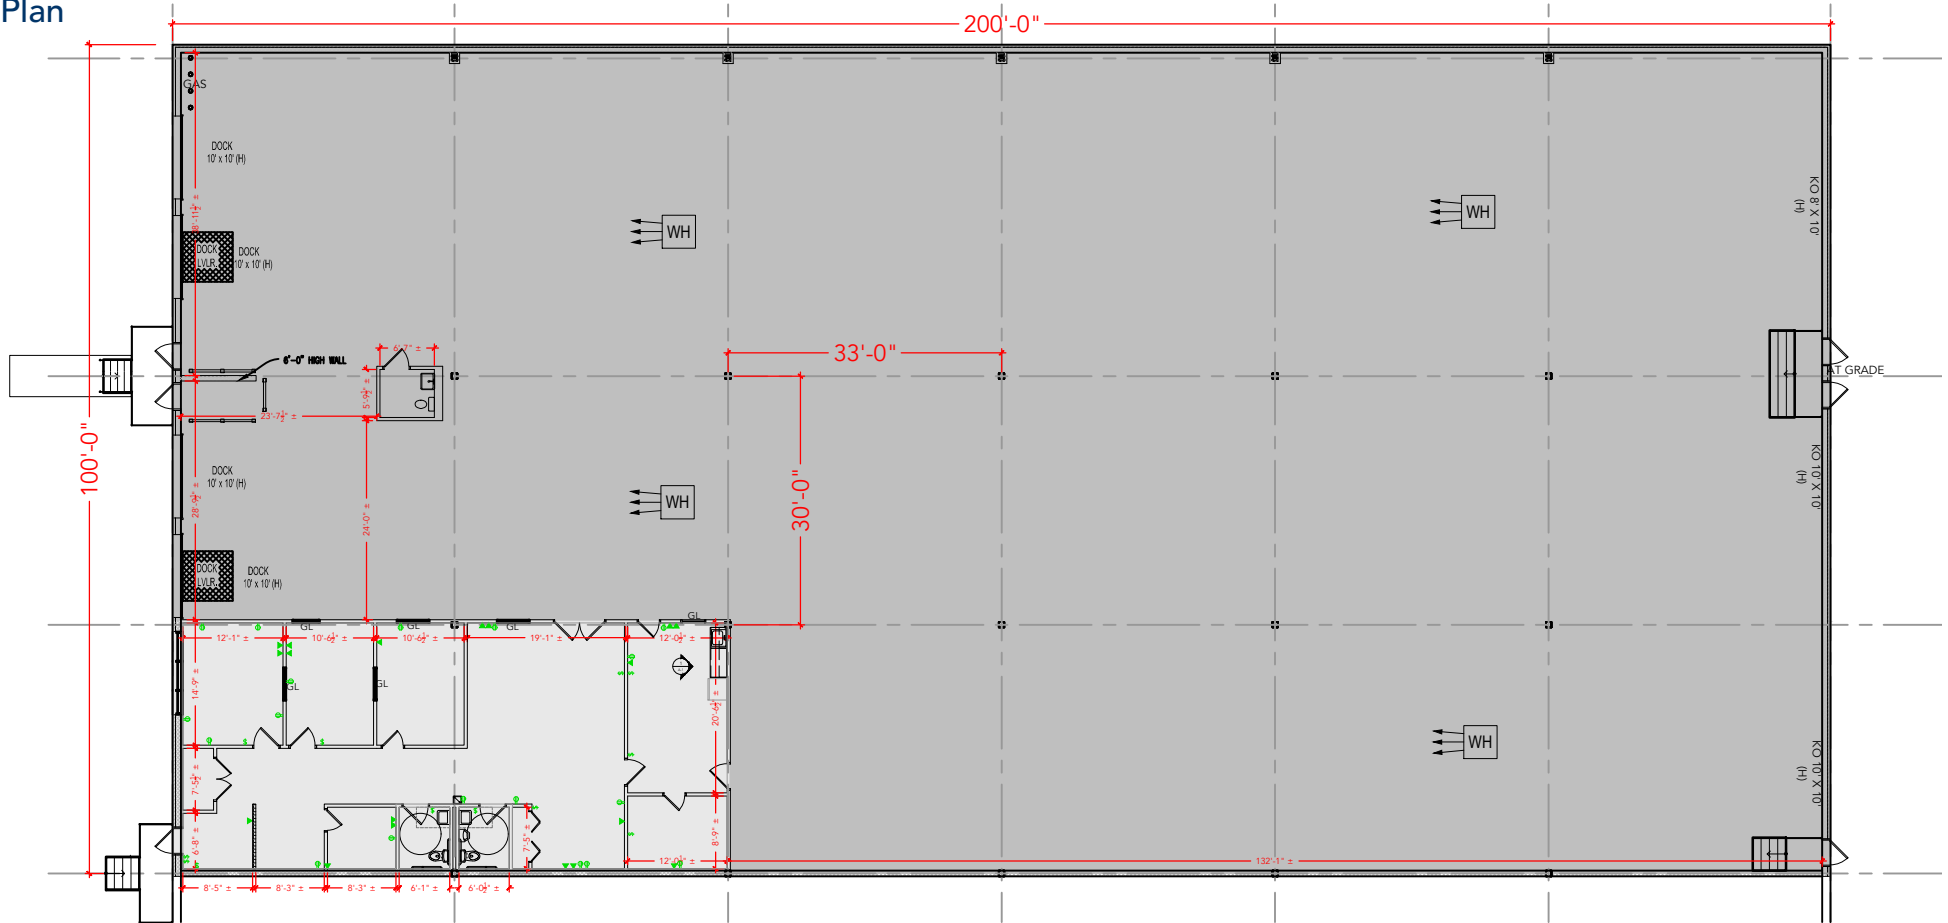

Floor Plan