


TOTAL SF AVAILABLE - 60,000 SF


OFFICE - 54,407 SF

WAREHOUSE - 5,593 SF

[Click to access 3D model](#)

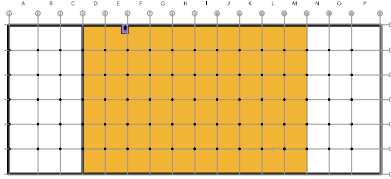

Key Plan

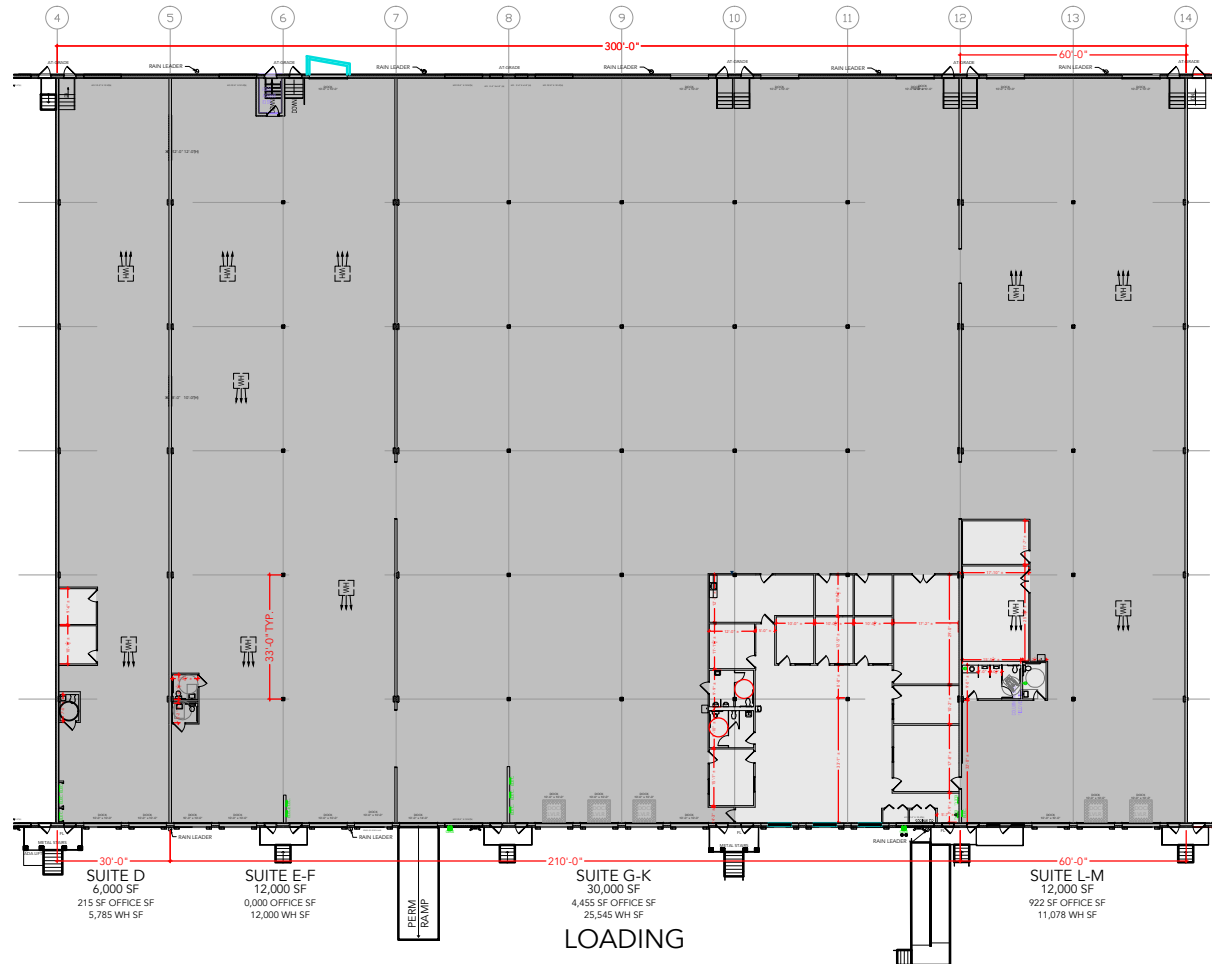

Floor Plan