



TOTAL SF AVAILABLE - 2,611 SF

[Click to access 3D model](#)

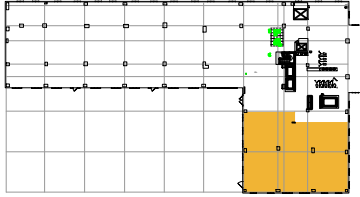

Key Plan

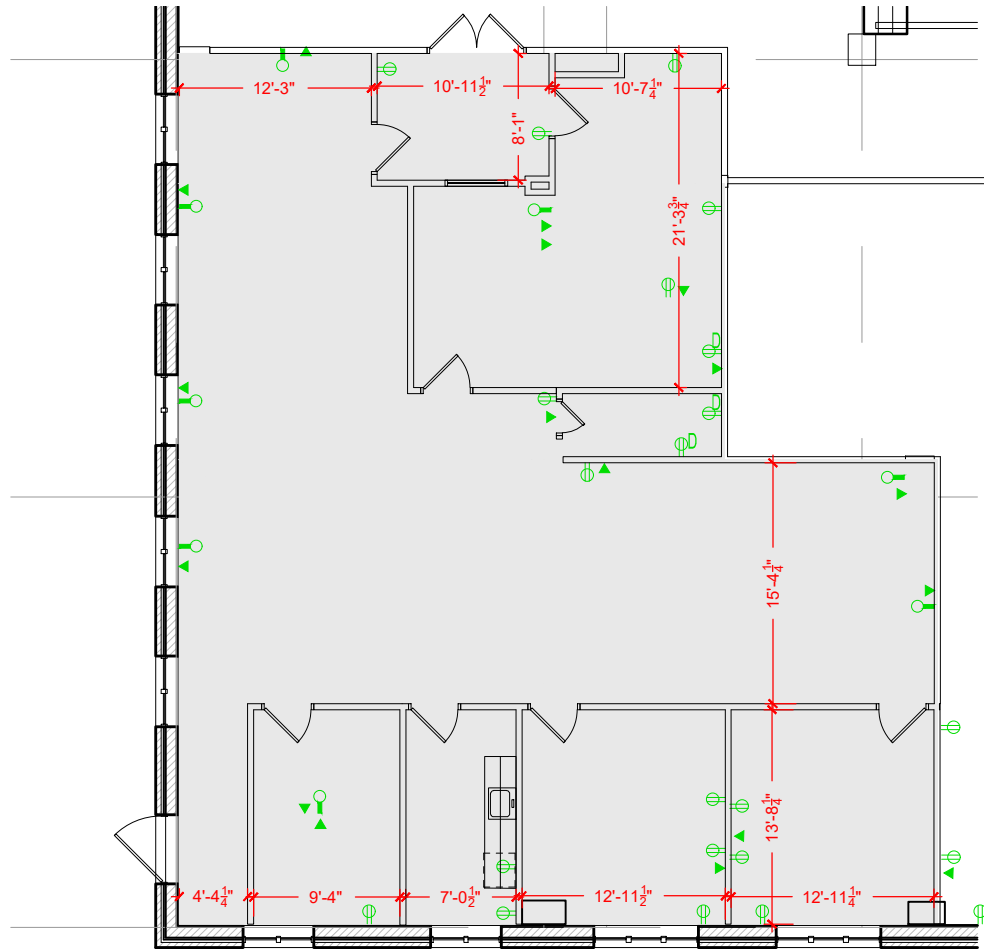

## Floor Plan