


[Click to access 3D model](#)

Key Plan

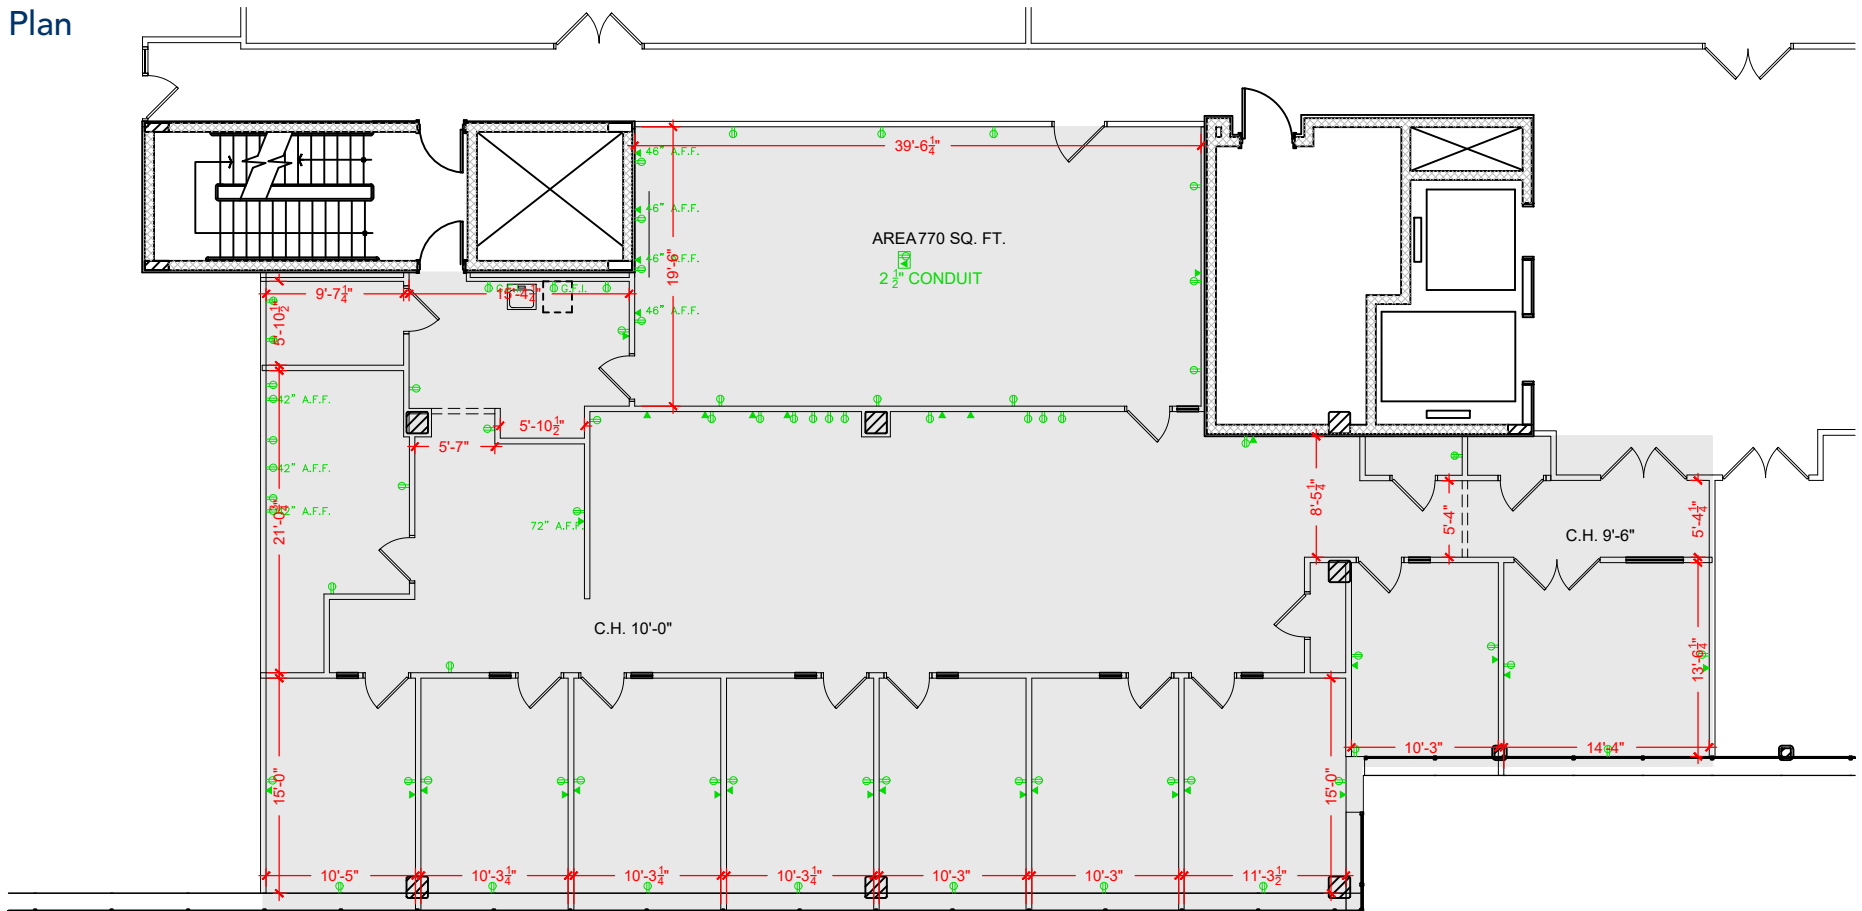

Floor Plan