


TOTAL SF AVAILABLE - 5,850 SF


OFFICE - 771 SF

WAREHOUSE SF - 5,079 SF

[Click to access 3D model](#)

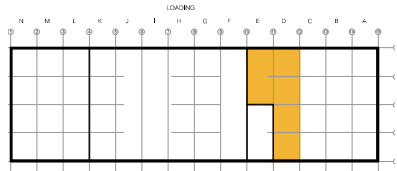

Key Plan

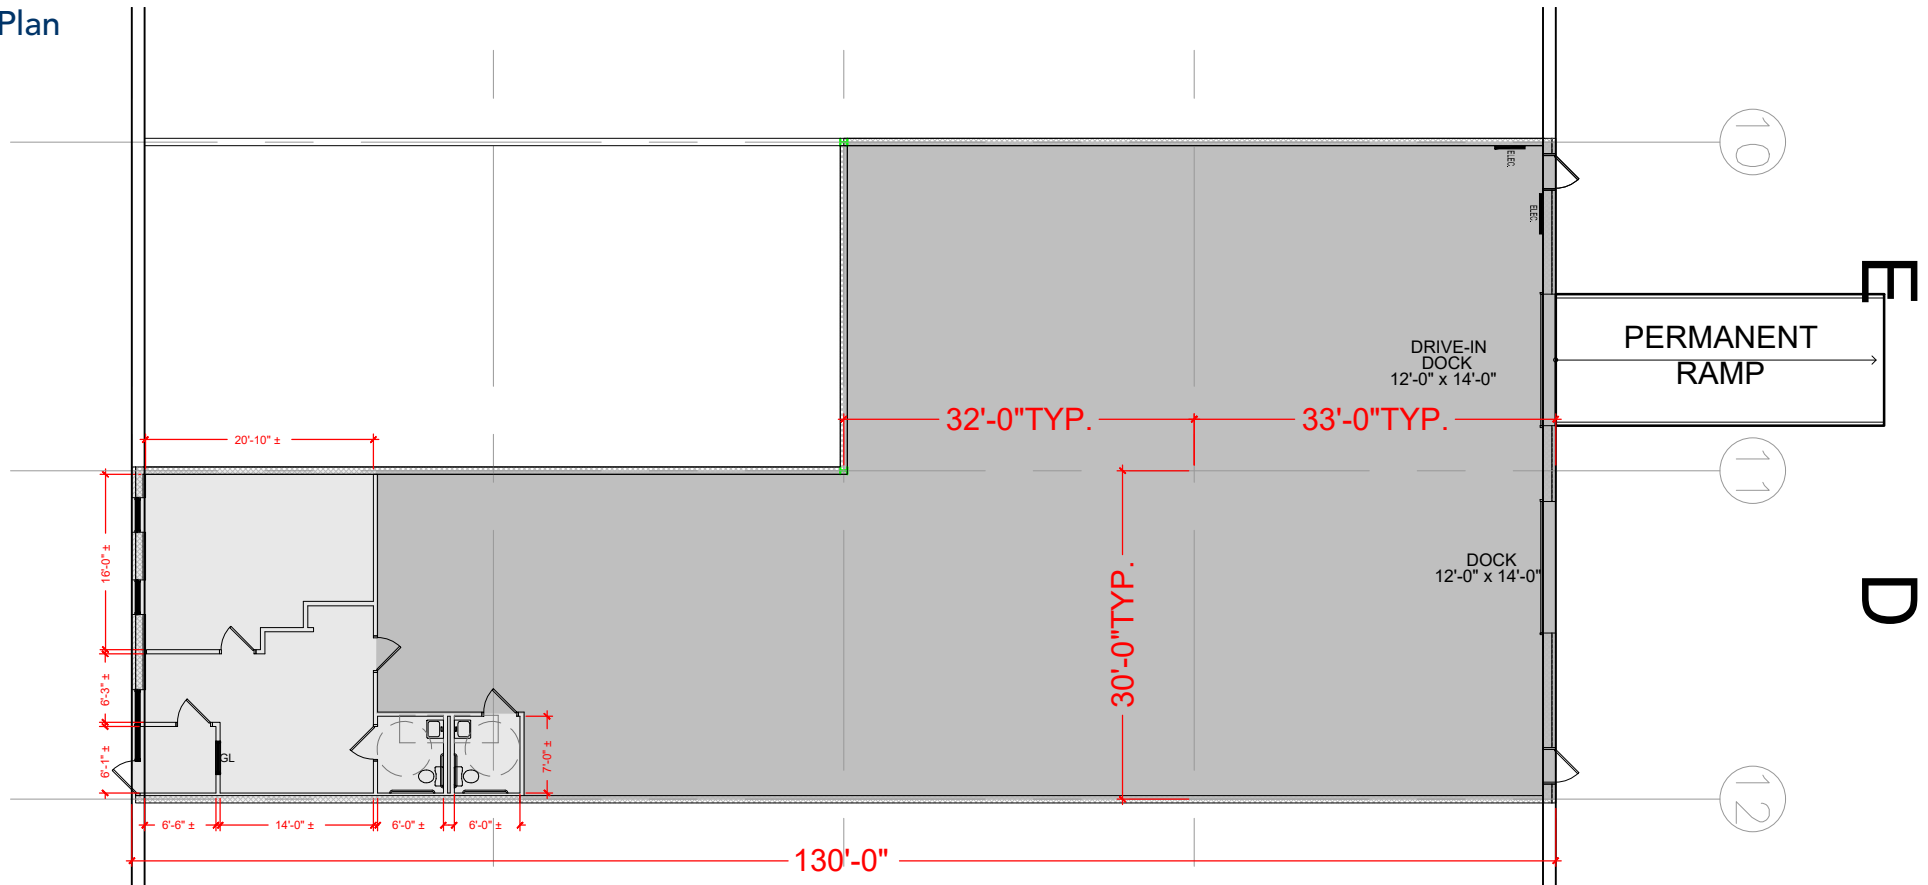

Floor Plan