


TOTAL SF AVAILABLE - 3,750 SF


OFFICE - 3,750 SF

WAREHOUSE SF - 0,000 SF

[Click to access 3D model](#)

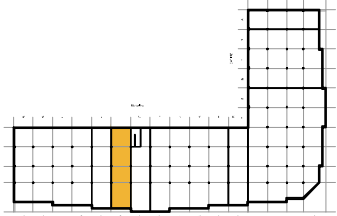

Key Plan

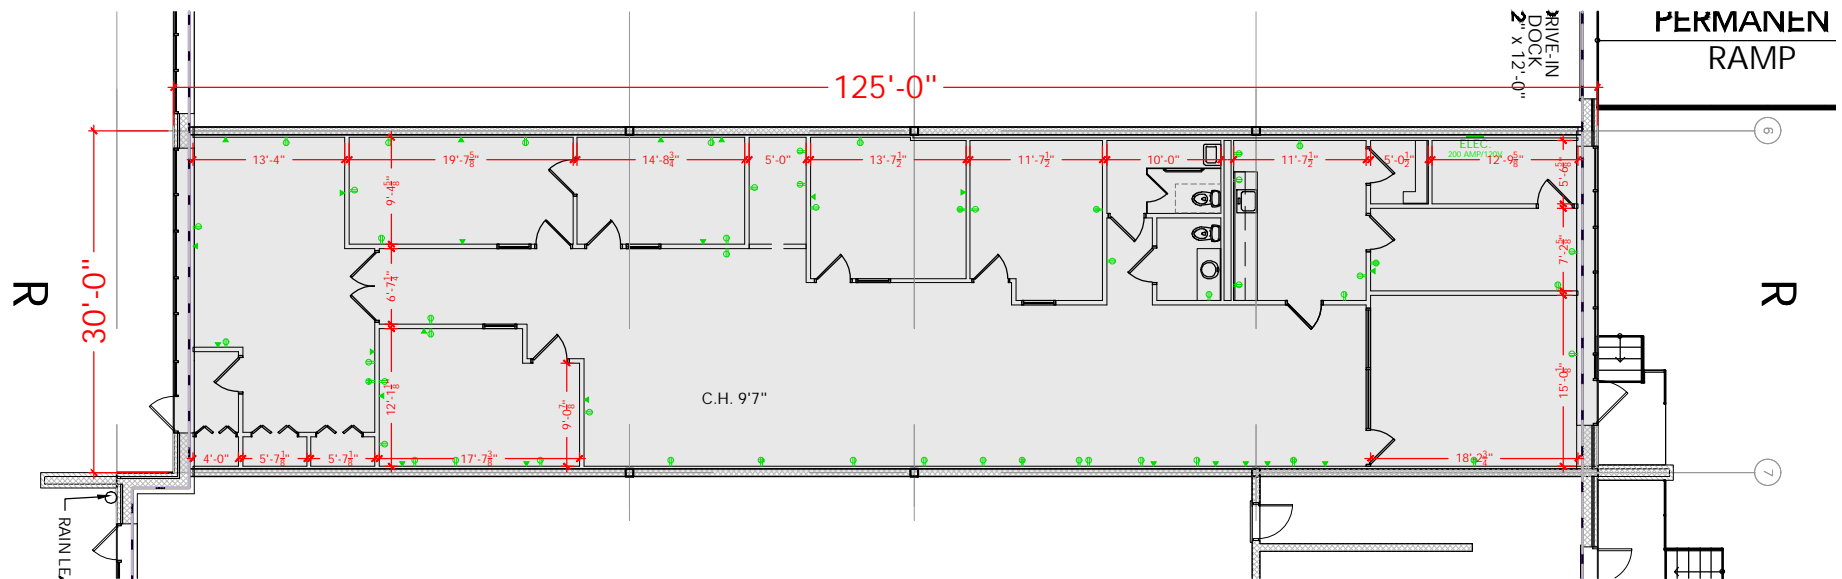

## Floor Plan