



TOTAL SF AVAILABLE - 33,628 RSF

OFFICE - 660 RSF

WAREHOUSE - 32,968 RSF

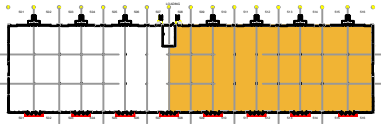

Key Plan

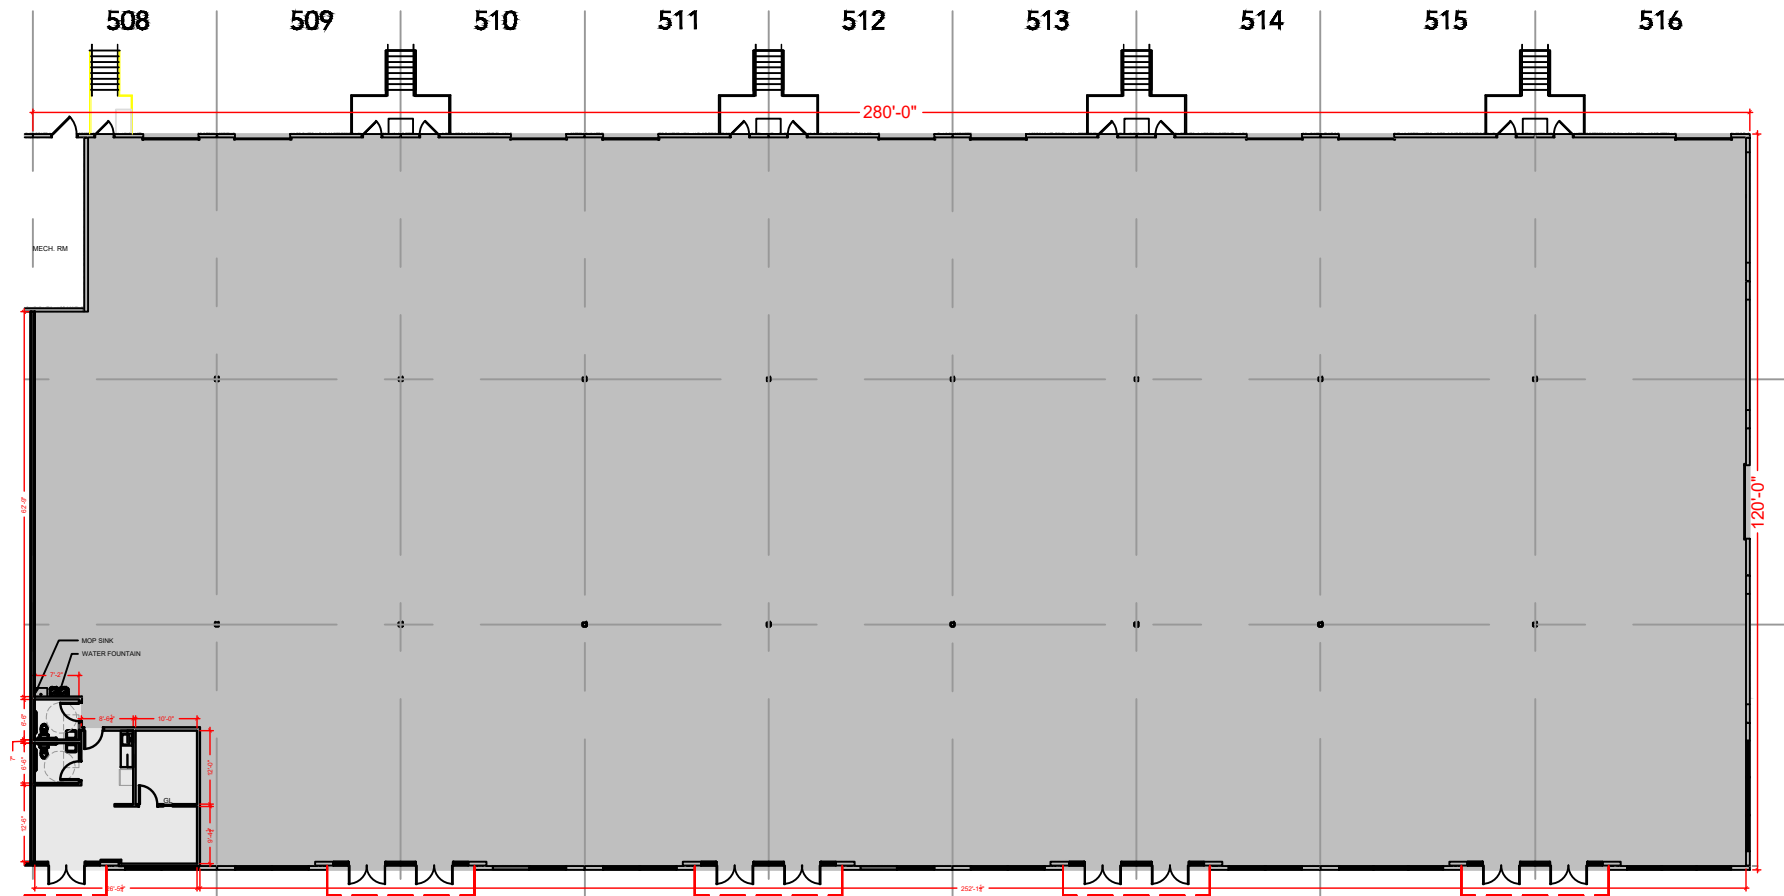

Floor Plan