



TOTAL SF AVAILABLE -6,667 SF

OFFICE - 1085 SF
WAREHOUSE - 5,582 SF

[Click to access 3D model](#)

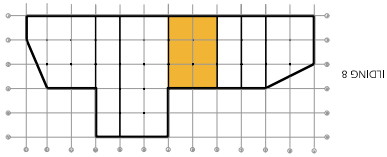

Key Plan

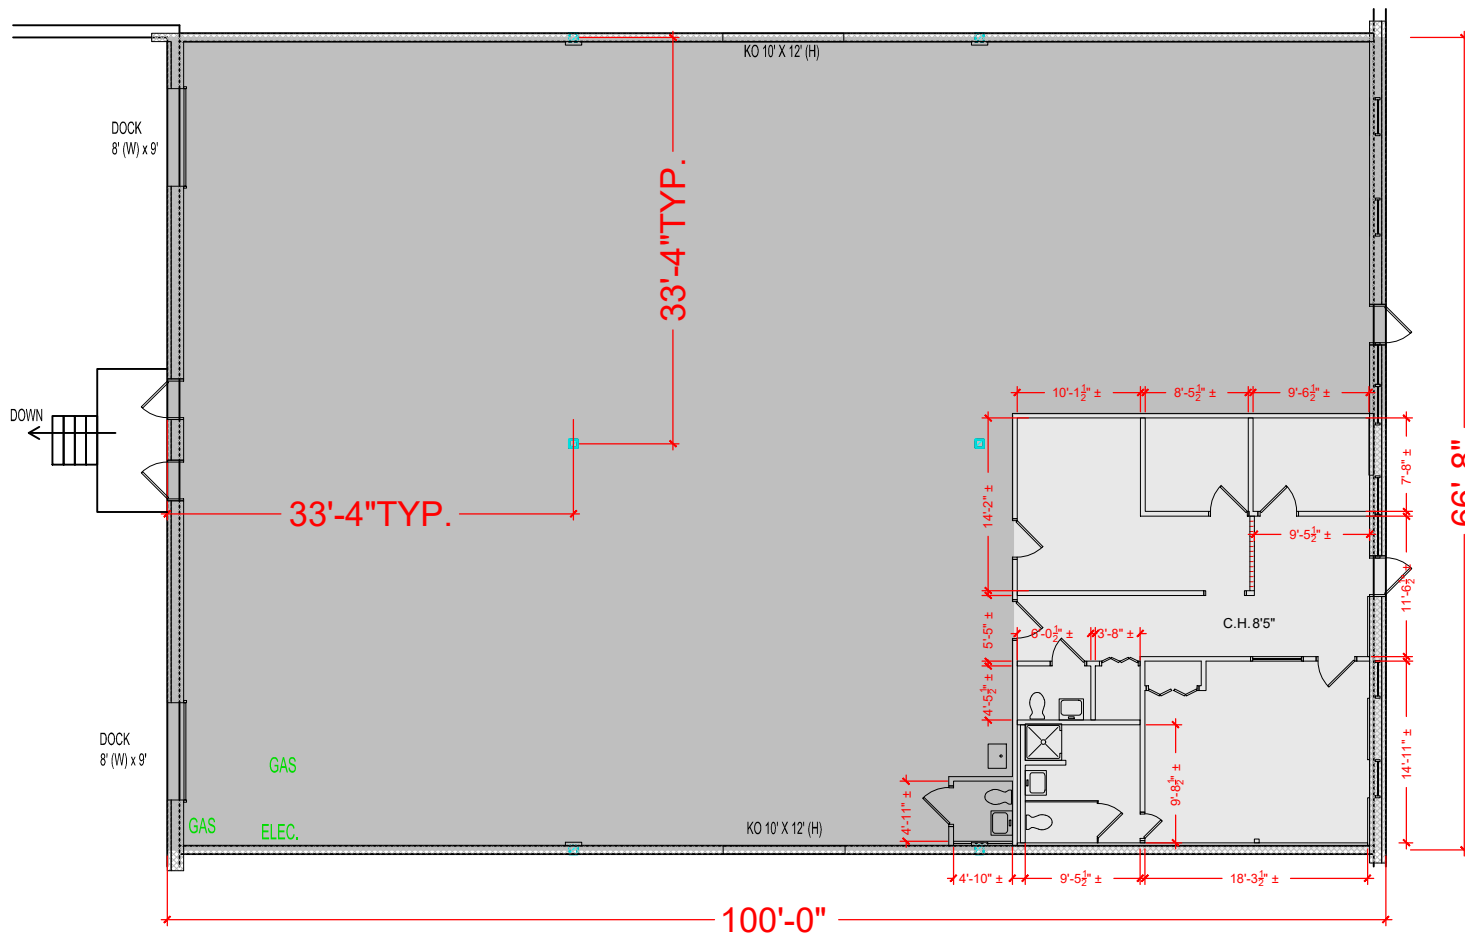

Floor Plan