


TOTAL SF AVAILABLE -2,498 RSF

OFFICE - 2,498 RSF


WAREHOUSE - 0,000 SF

*INCLUDED % OF METER ROOM

[Click to access 3D model](#)

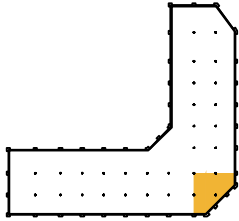

Key Plan

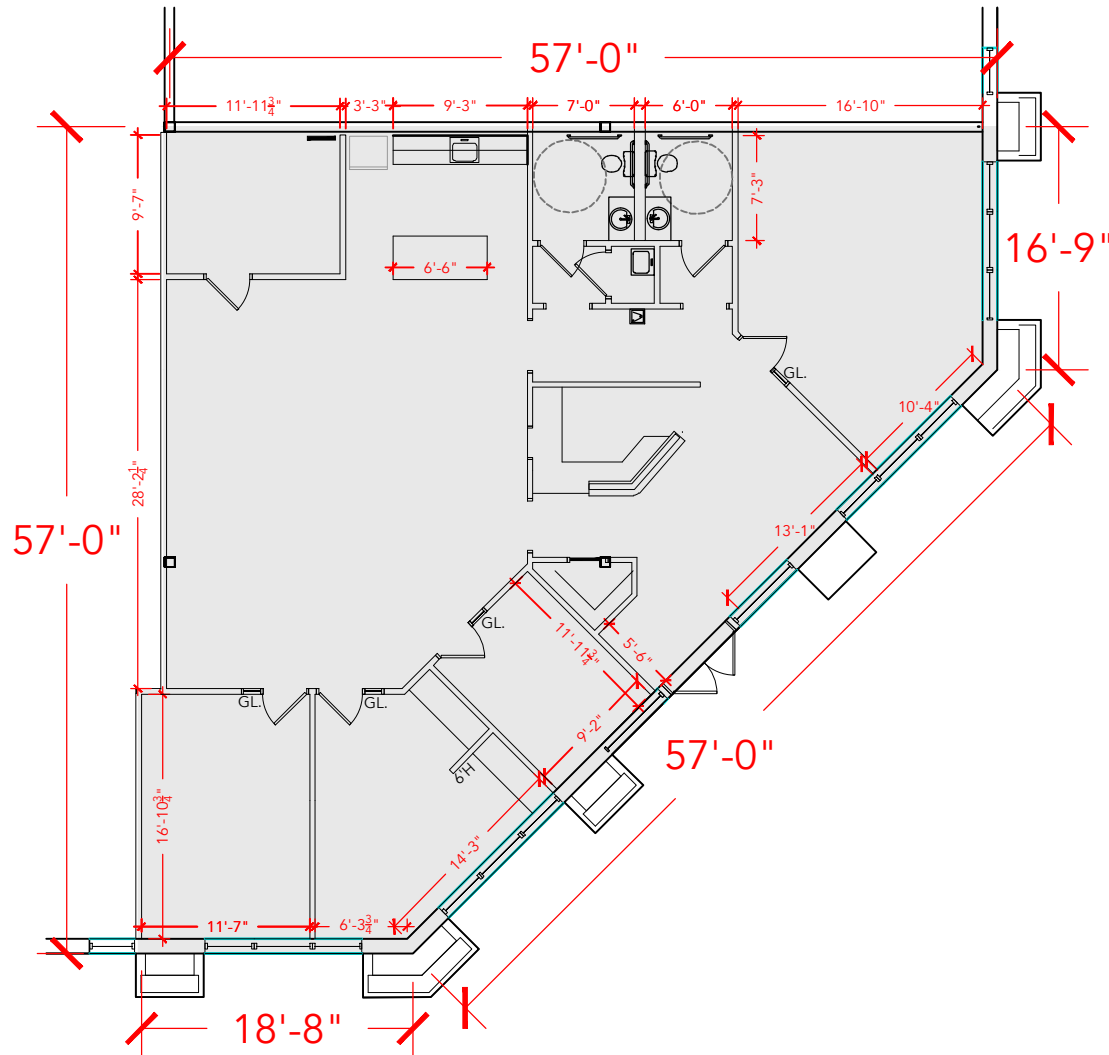

Floor Plan