



TOTAL SF AVAILABLE - 5,439 RSF(16%)

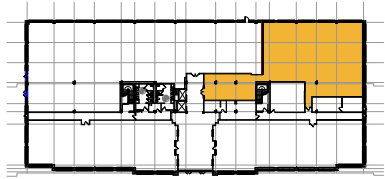

Key Plan

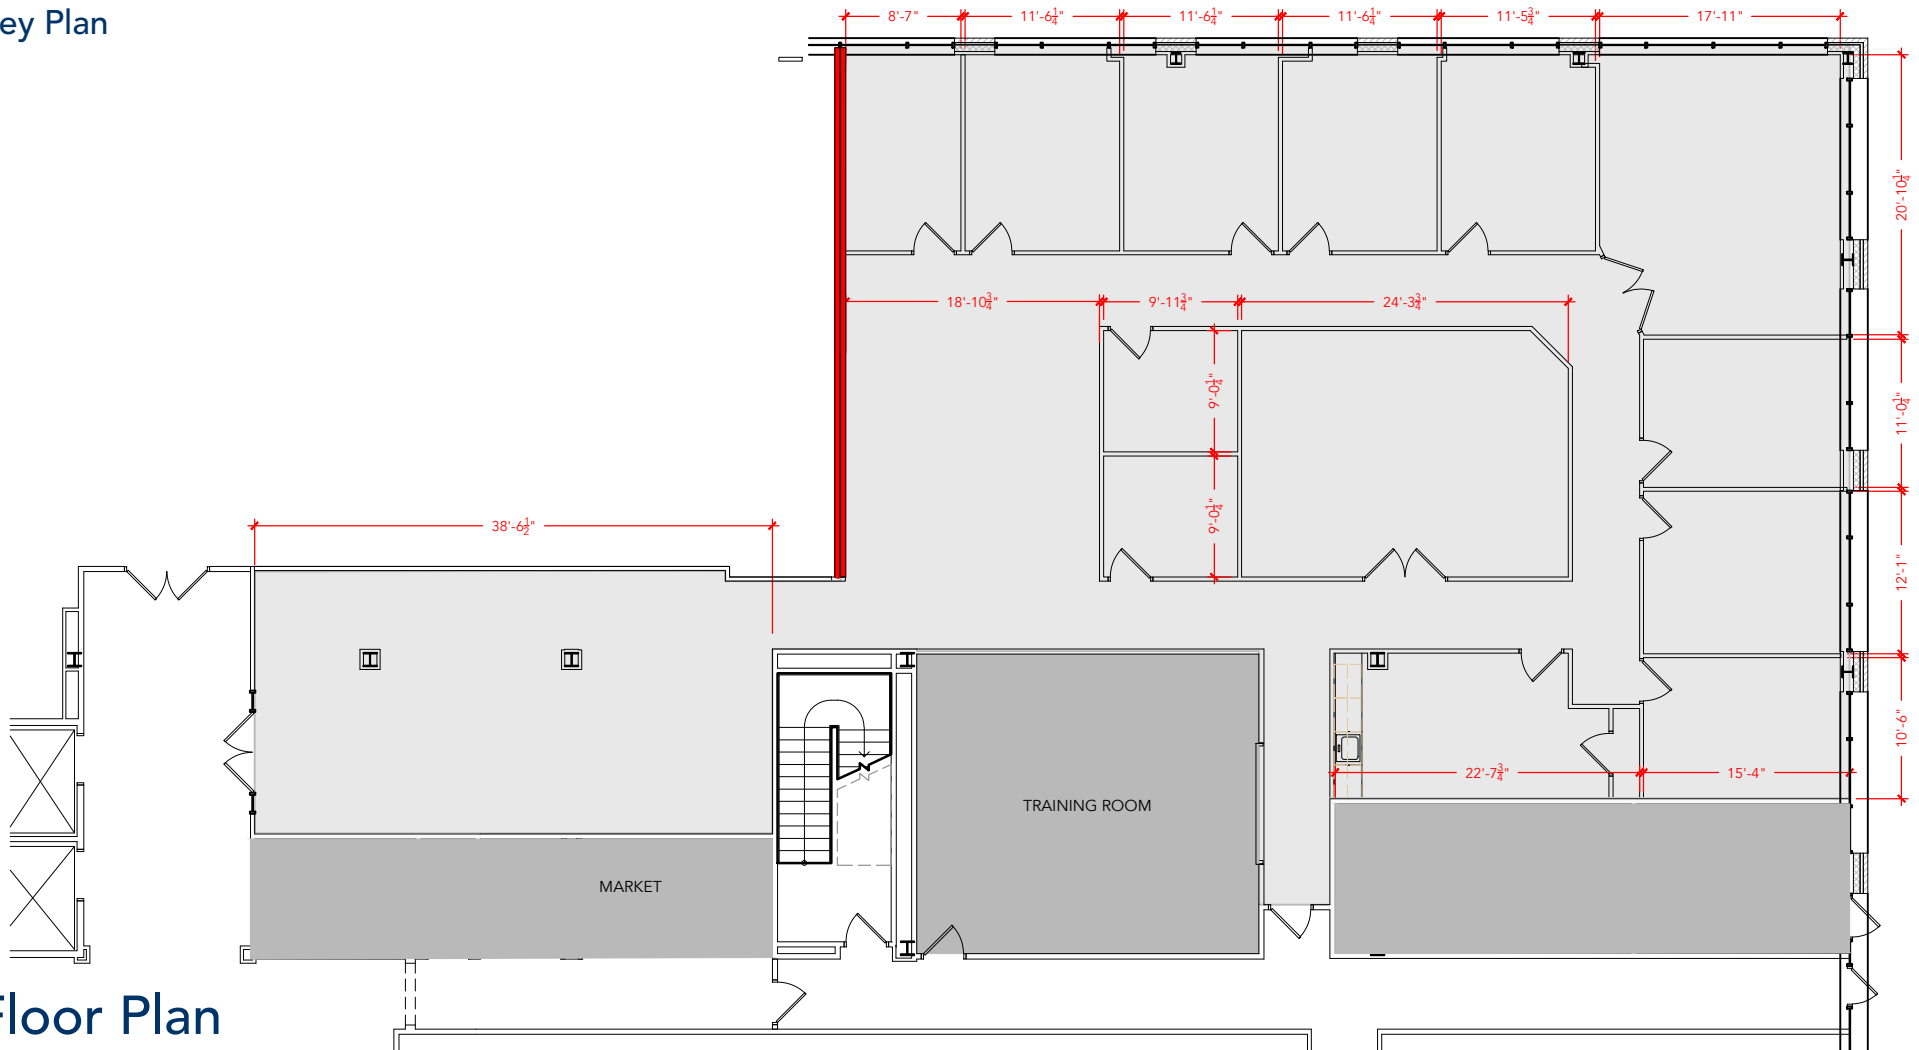

Floor Plan