

LYNWOOD EXECUTIVE CENTER


6095 MARSHALEE DRIVE, ELKRIDGE, MD 21075 SUITE 100



TOTAL SF AVAILABLE - 17,122 RSF (16%)

Click to access3D model

Key Plan

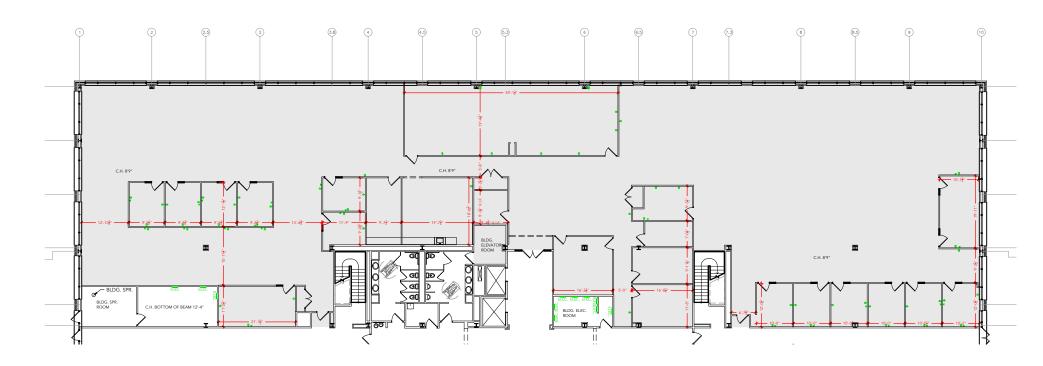

Floor Plan