



TOTAL SF AVAILABLE -7,808 RSF(16%)

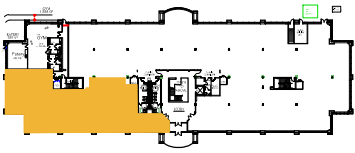

Key Plan

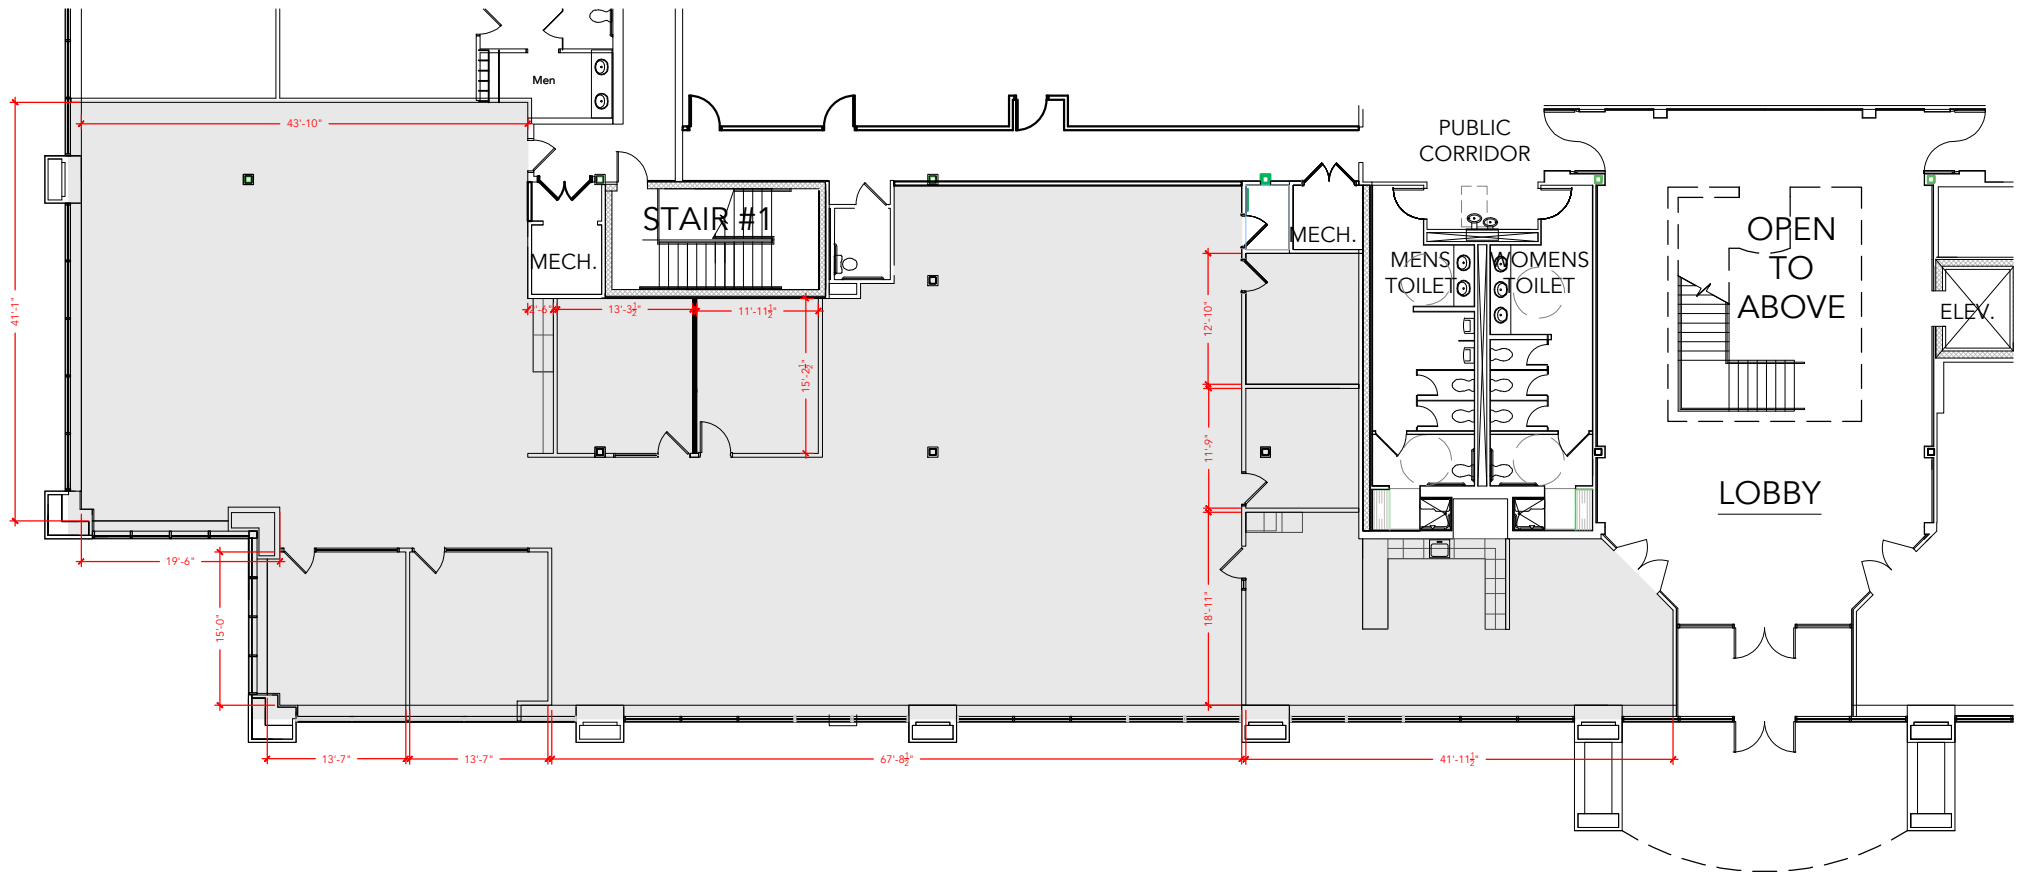

Floor Plan