



TOTAL SF AVAILABLE - 52,371 RSF

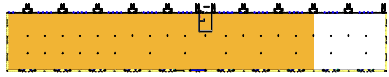

Key Plan

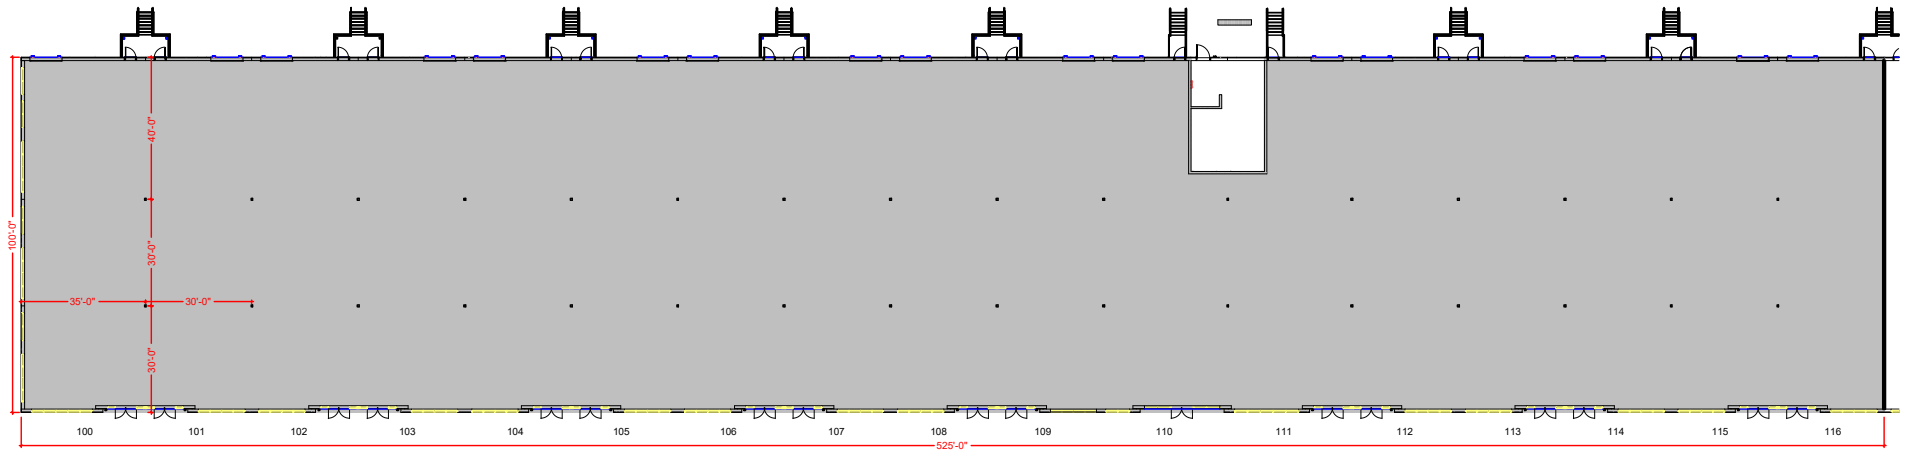

Floor Plan