



TOTAL SF AVAILABLE -1,811 RSF

OFFICE - 315 RSF  
WAREHOUSE - 1,496 RSF

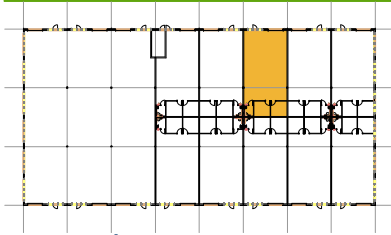

Key Plan

150

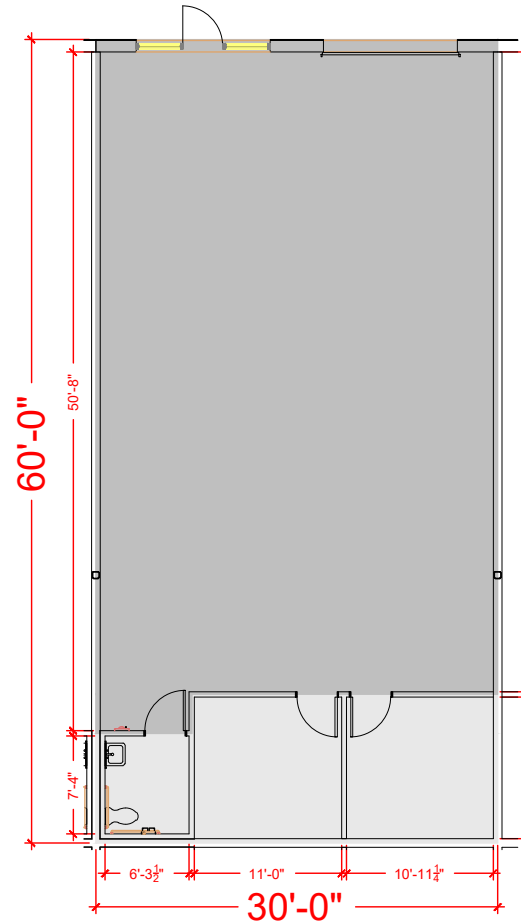

## Floor Plan