



TOTAL SF AVAILABLE -1,682 RSF

OFFICE - 315 RSF
WAREHOUSE - 1,367 RSF

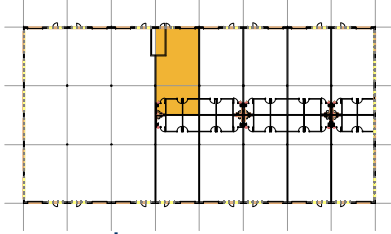

Key Plan

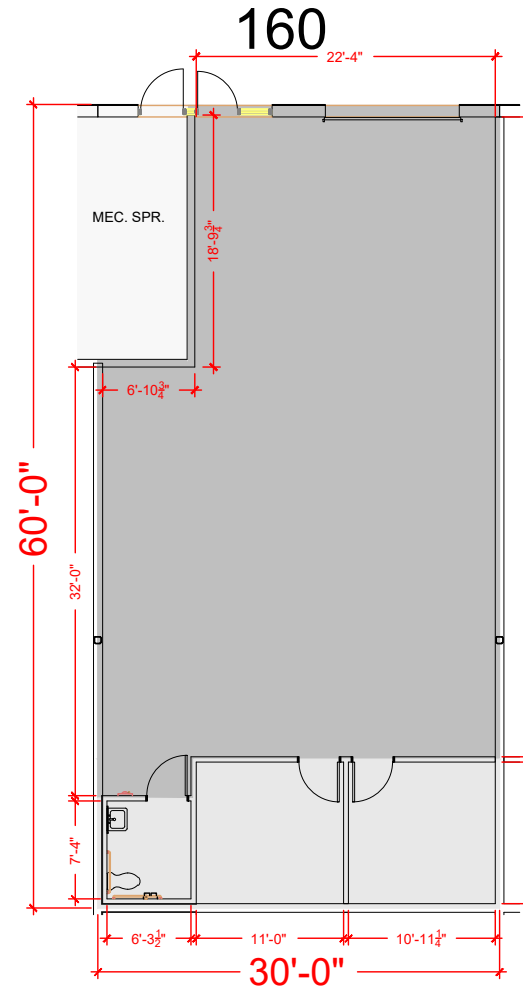

Floor Plan