
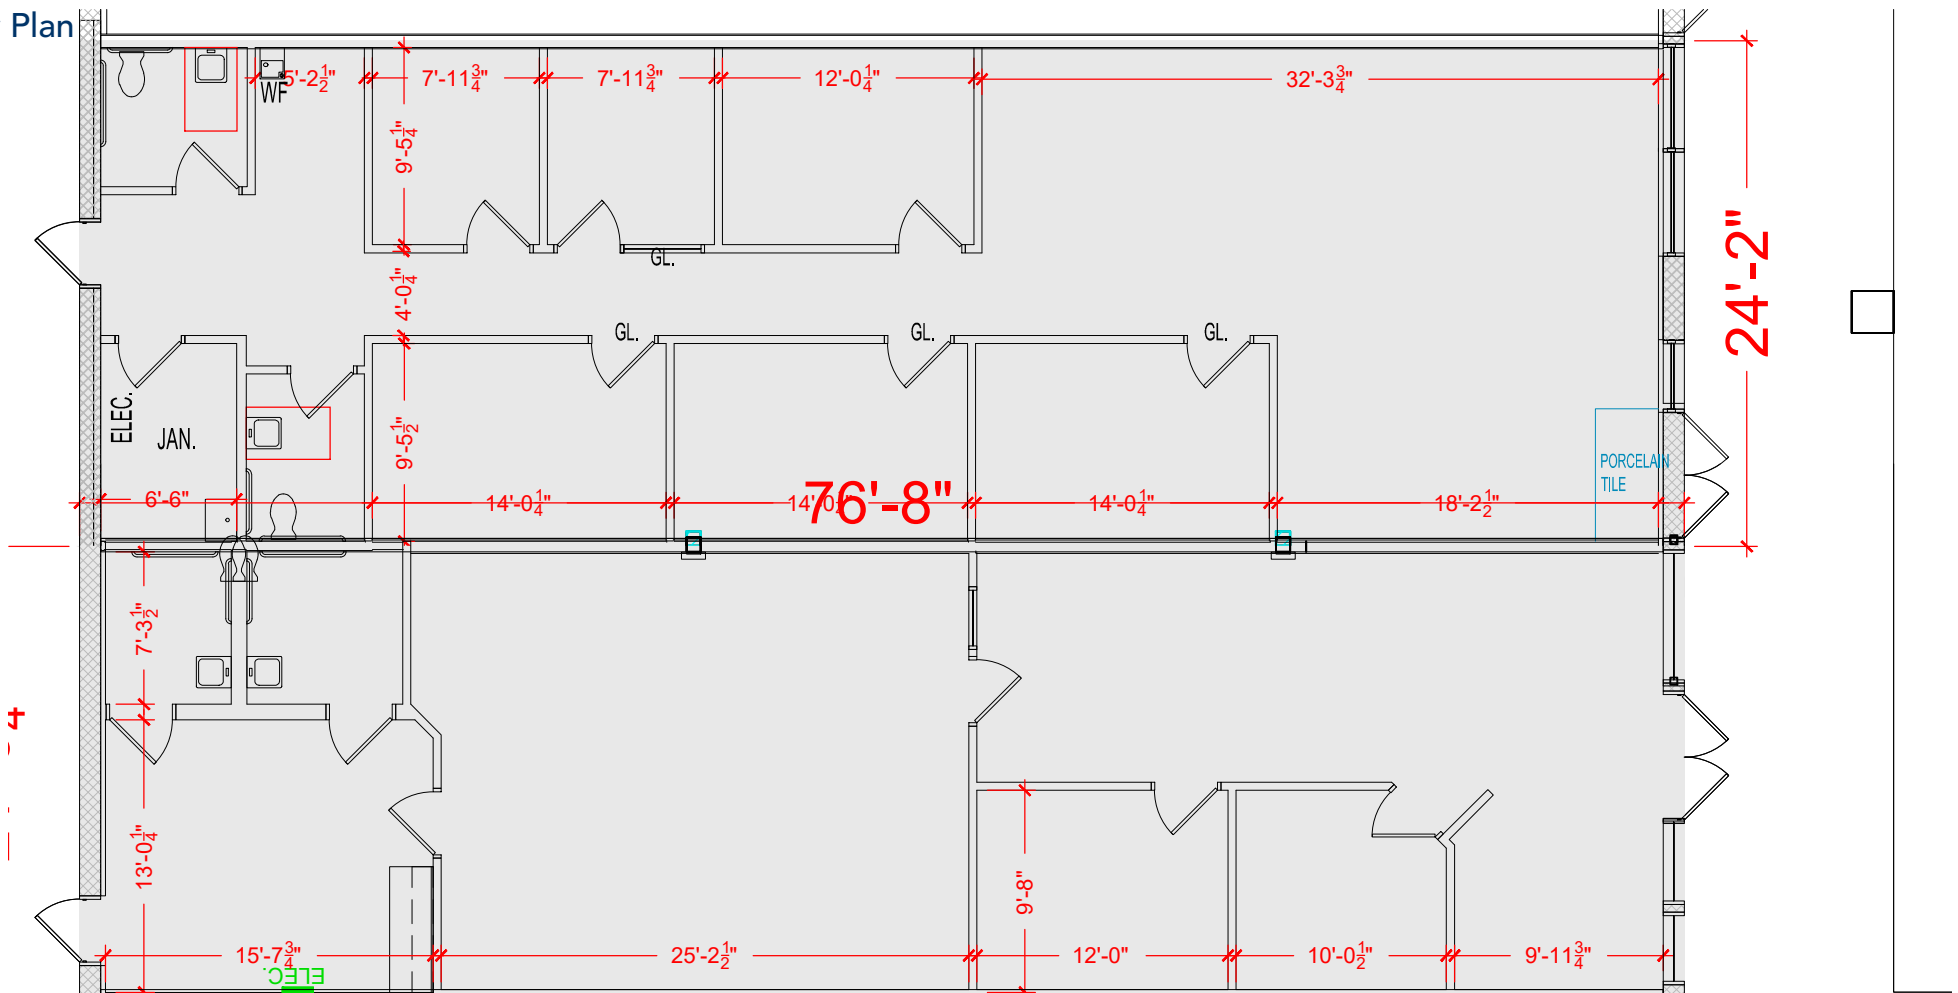


TOTAL SF AVAILABLE - 3,531 SF

[Click to access 3D model](#)

Key Plan

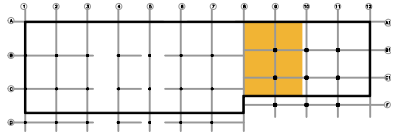

Floor Plan