



TOTAL SF AVAILABLE -1,709 RSF (12%)

[Click to access 3D model](#)

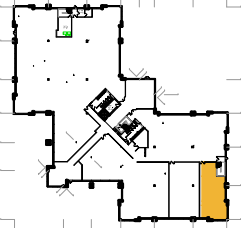

Key Plan

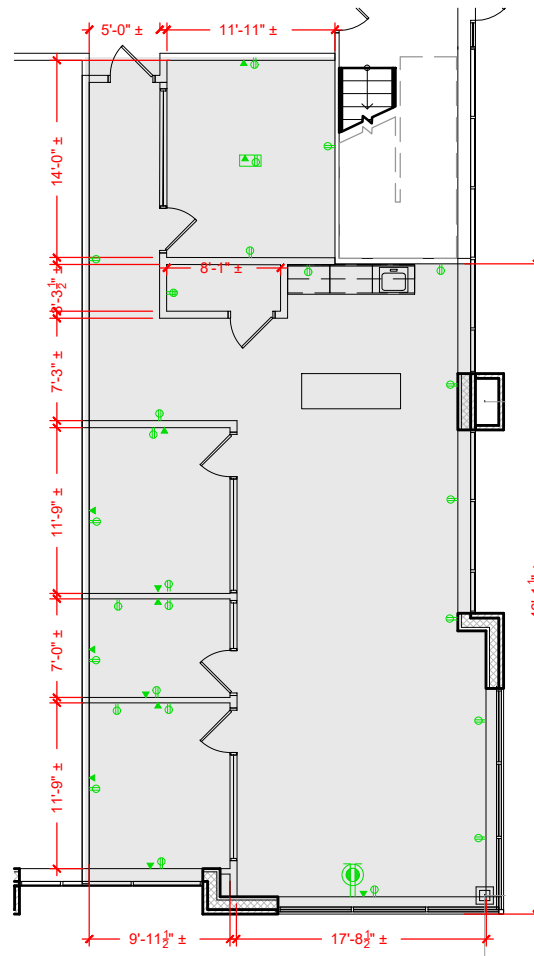

Floor Plan