


Key Plan

TOTAL SF AVAILABLE - 2,076 SF

OFFICE - 2,076 SF

WAREHOUSE - 0,000 SF

[Click to access 3D model](#)

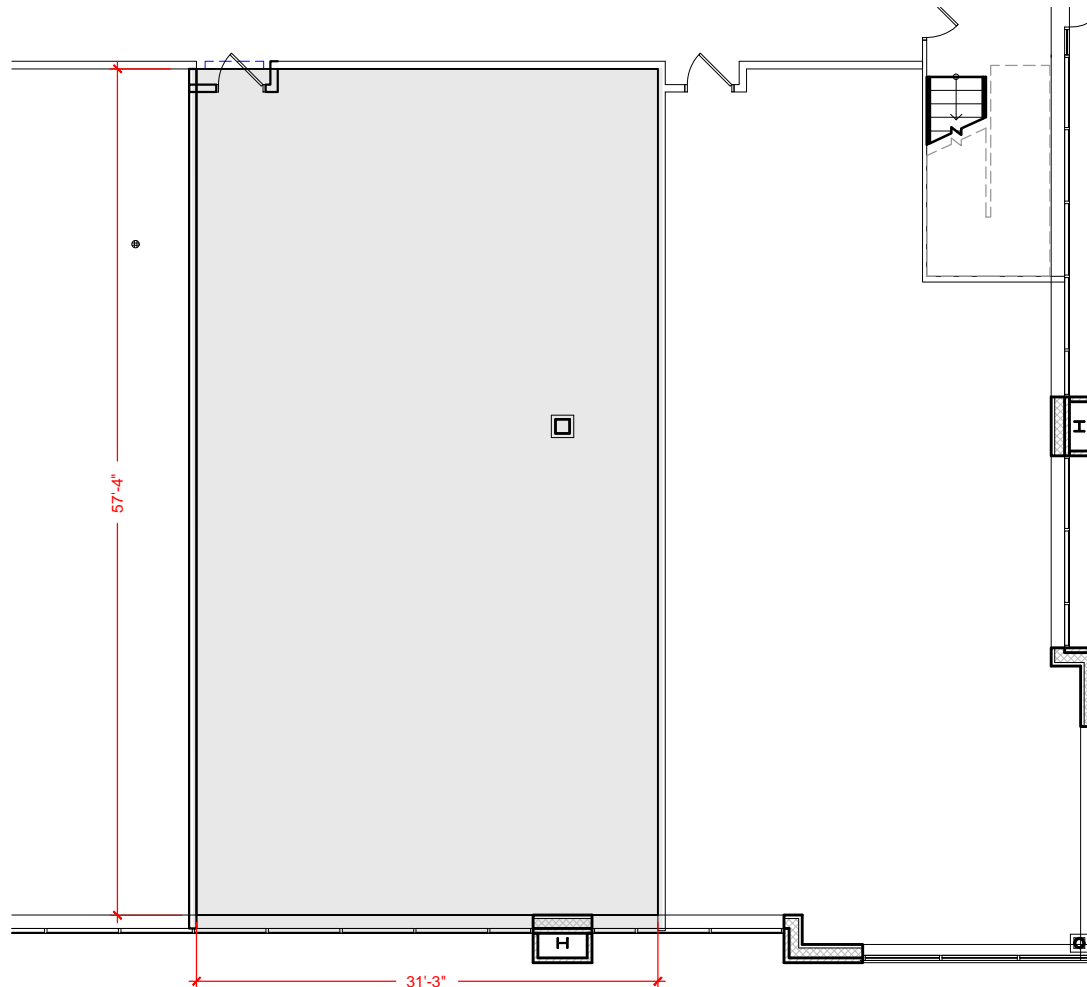

Floor Plan