



TOTAL SF AVAILABLE -2,544 RSF(12%)

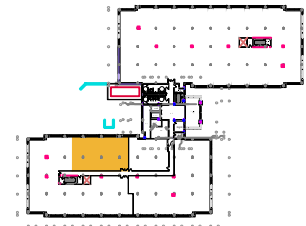

Key Plan

[Click to access 3D model](#)

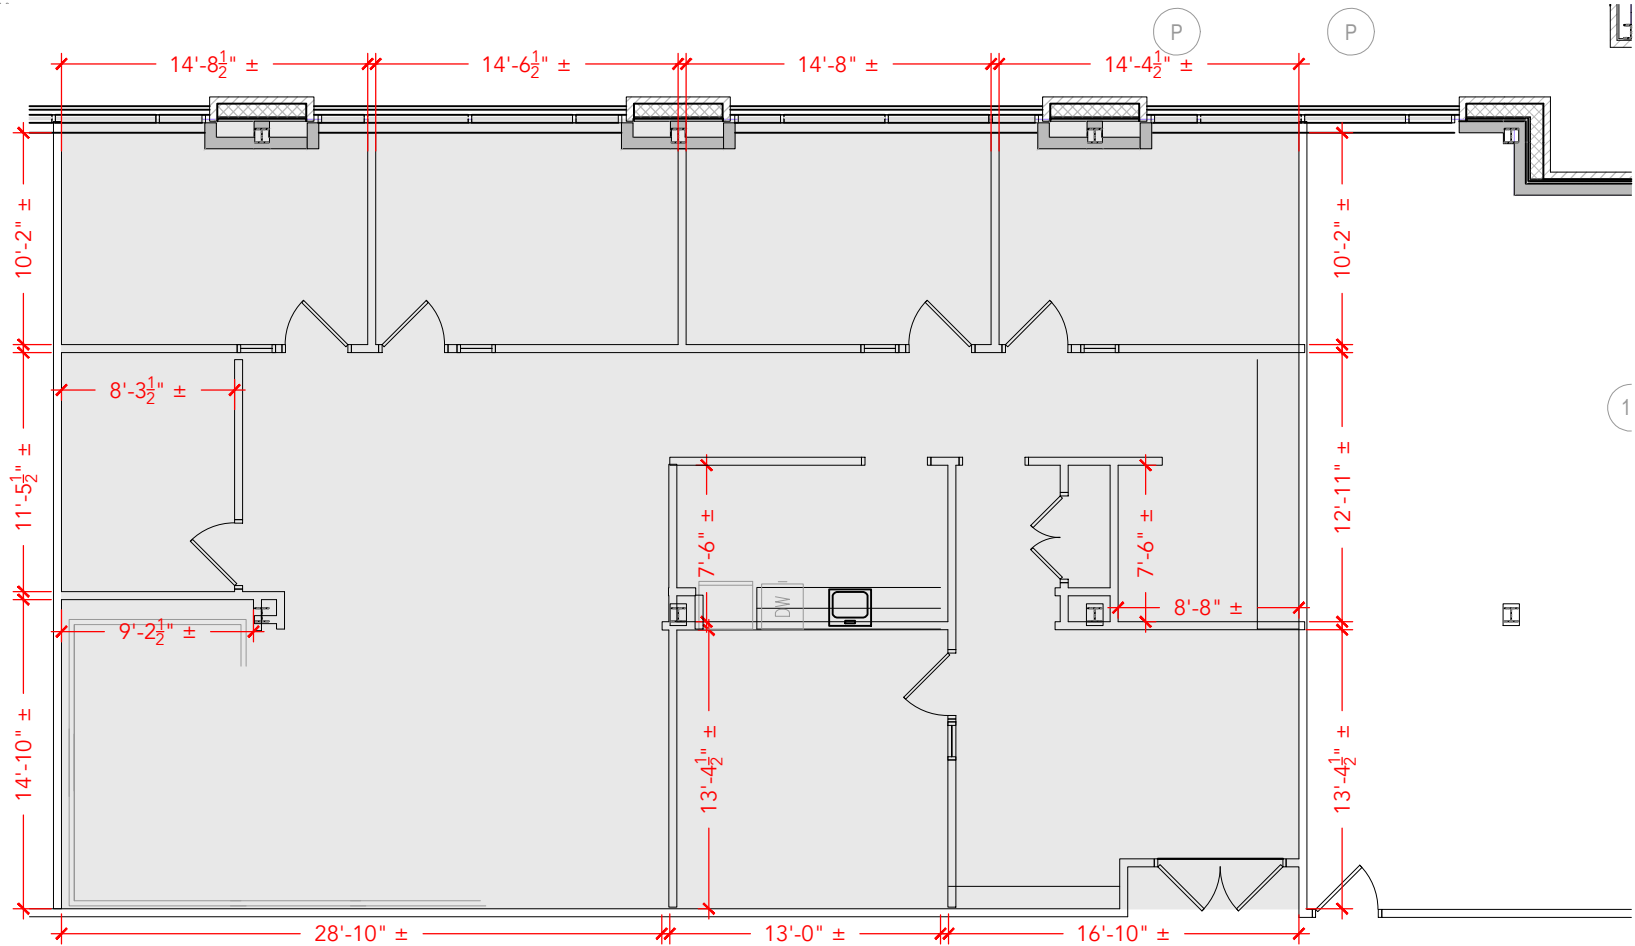

Floor Plan