
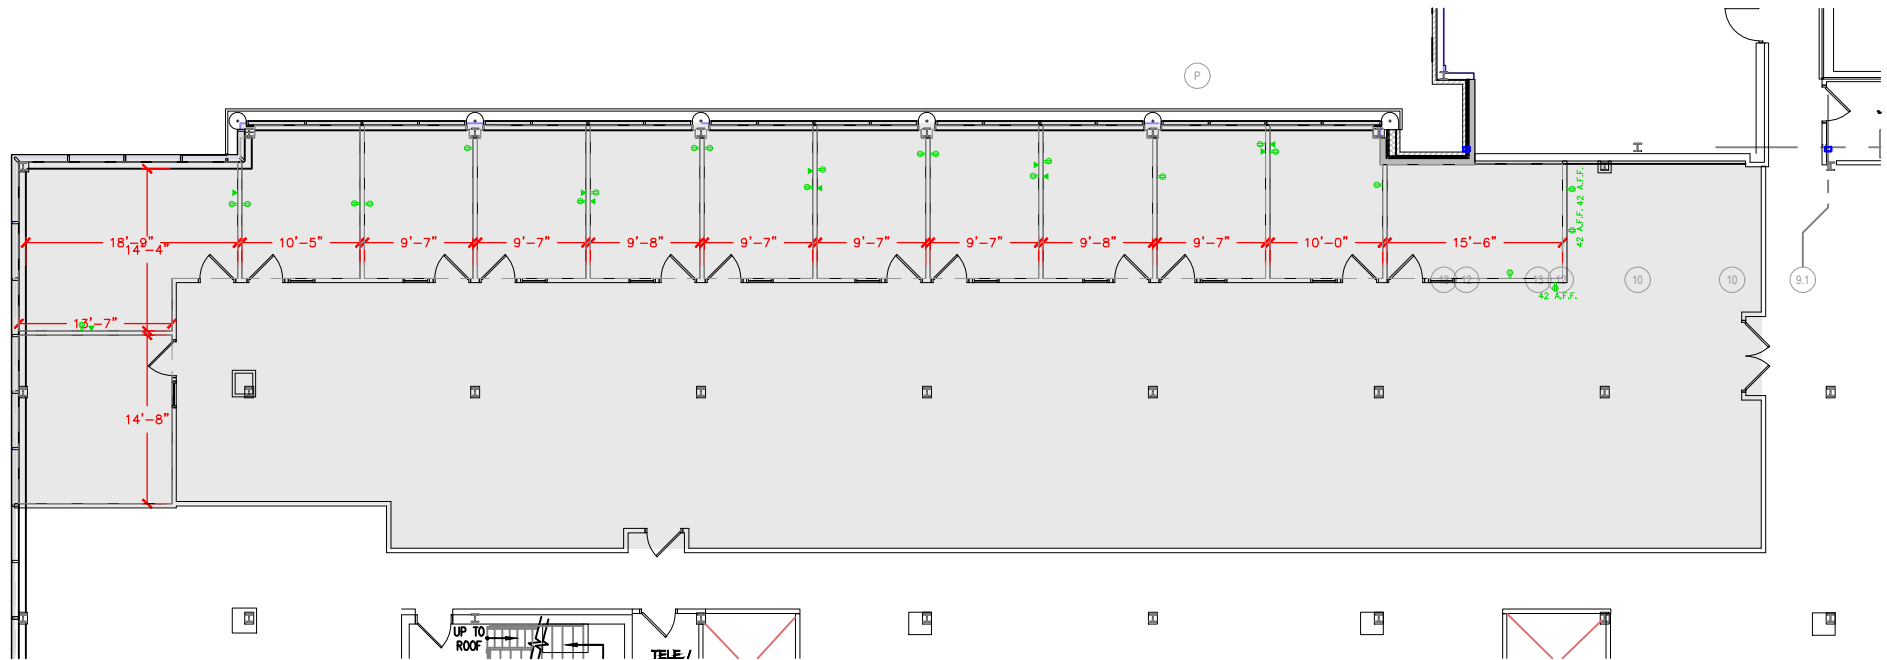


TOTAL SF AVAILABLE - 6,177 RSF (12%)

[Click to access 3D model](#)

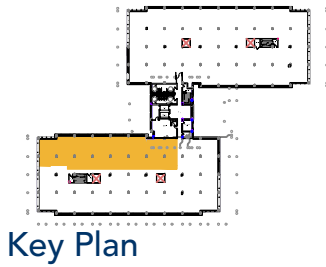

Floor Plan