



TOTAL SF AVAILABLE - 1,150 RSF(12%)

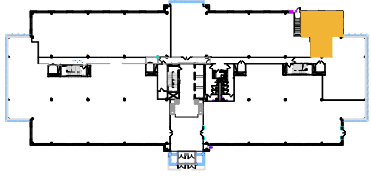

Key Plan

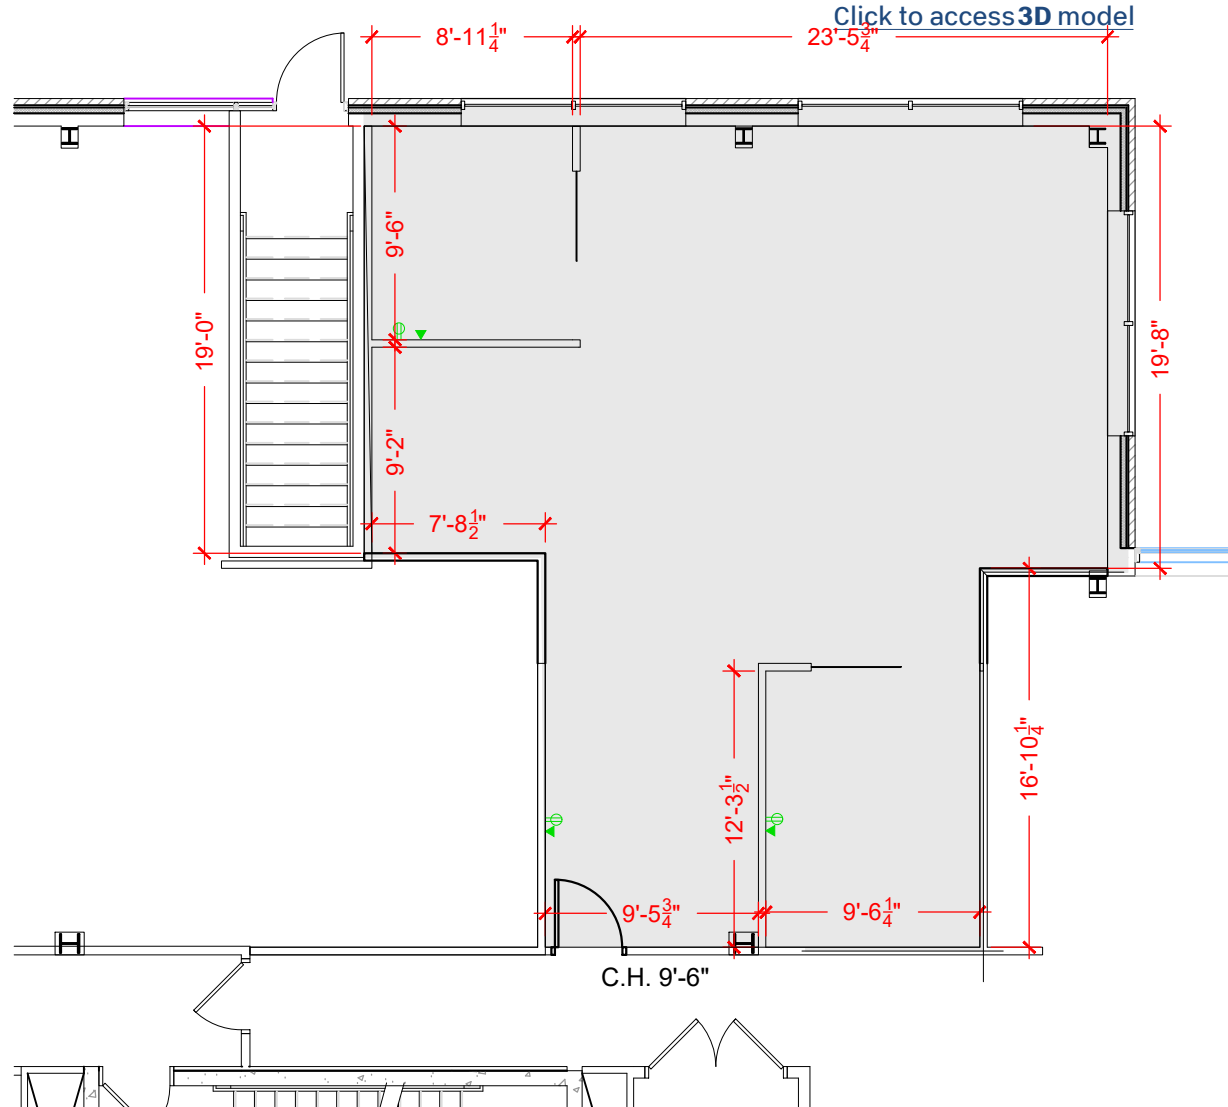

Floor Plan