


**TOTAL SF AVAILABLE -8,400 SF**


**OFFICE - 8,400 SF**

**WAREHOUSE - 0,000 SF**

[Click to access 3D model](#)

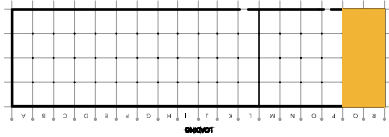

Key Plan

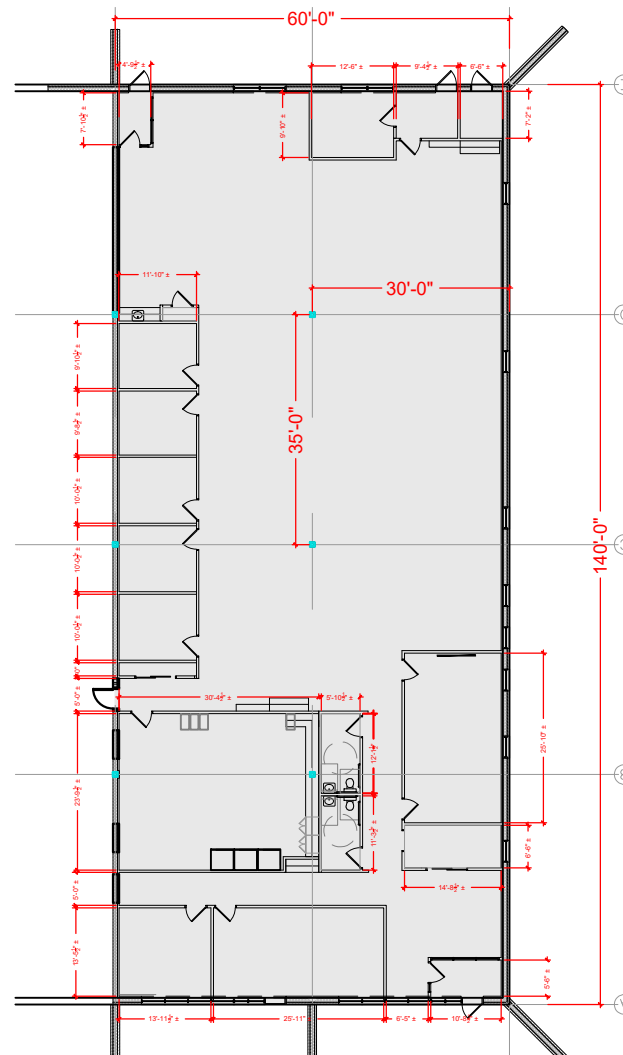

Floor Plan