



TOTAL SF AVAILABLE - 5,002 RSF(12%)

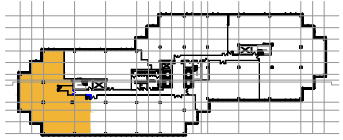

Key Plan

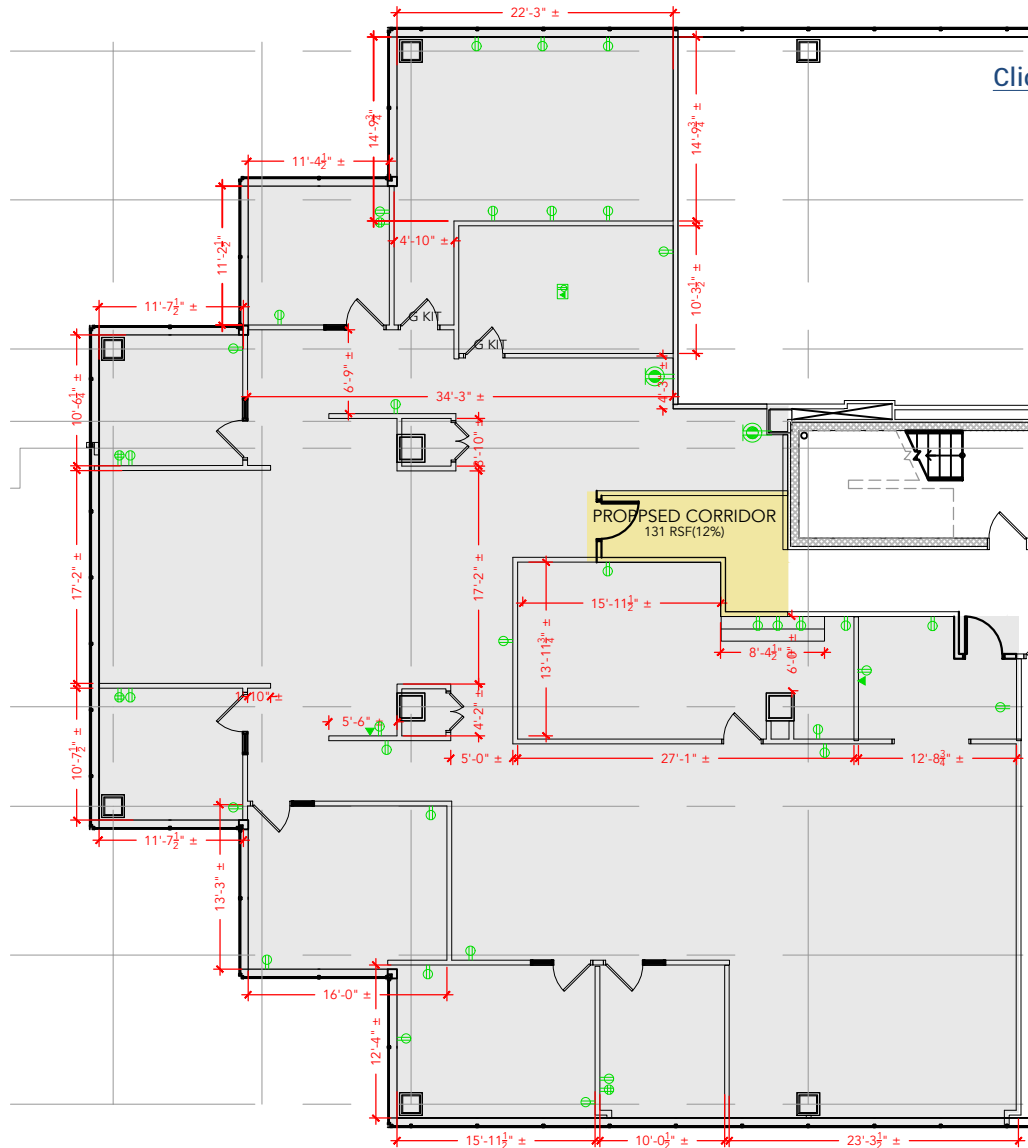

[Click to access 3D model](#)

Floor Plan