


Key Plan

**TOTAL SF AVAILABLE - 6,638 RSF**  
(INCLUDES % OF MECH. RM)

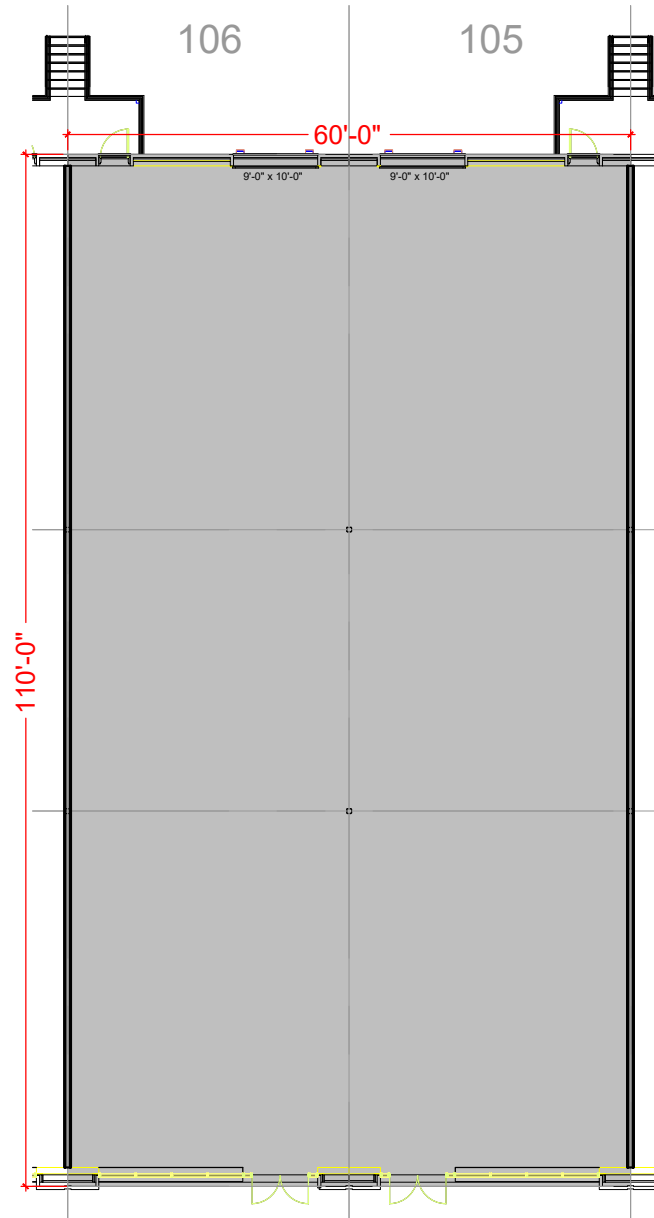

Floor Plan