


COLUMBIA CORPORATE PARK


8850 STANFORD BLVD. COLUMBIA, MD 21045 SUITE 3000 & 3600

TOTAL SF AVAILABLE - 8,241 RSF(16%)

Click to access 3D model

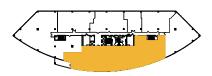

Key Plan

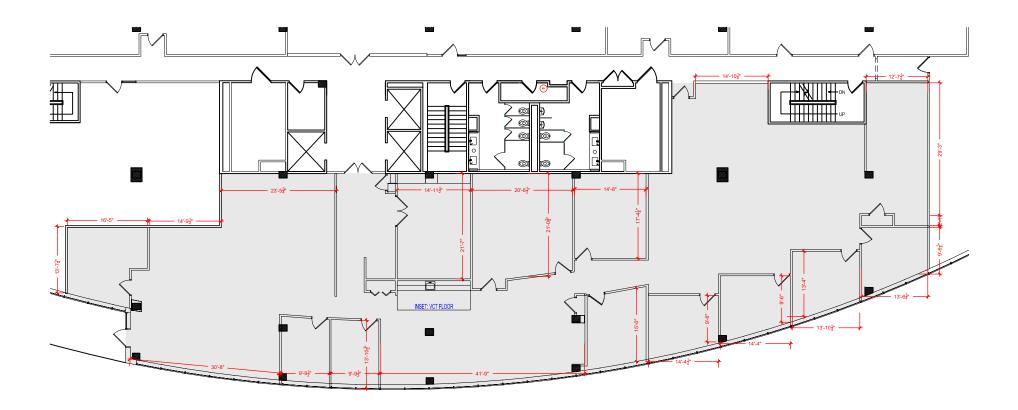

Floor Plan