


**TOTAL SF AVAILABLE -3,600 SF**


**OFFICE - 476 SF**

**WAREHOUSE - 3,124 SF**

[Click to access 3D model](#)

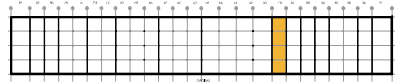

## Key Plan

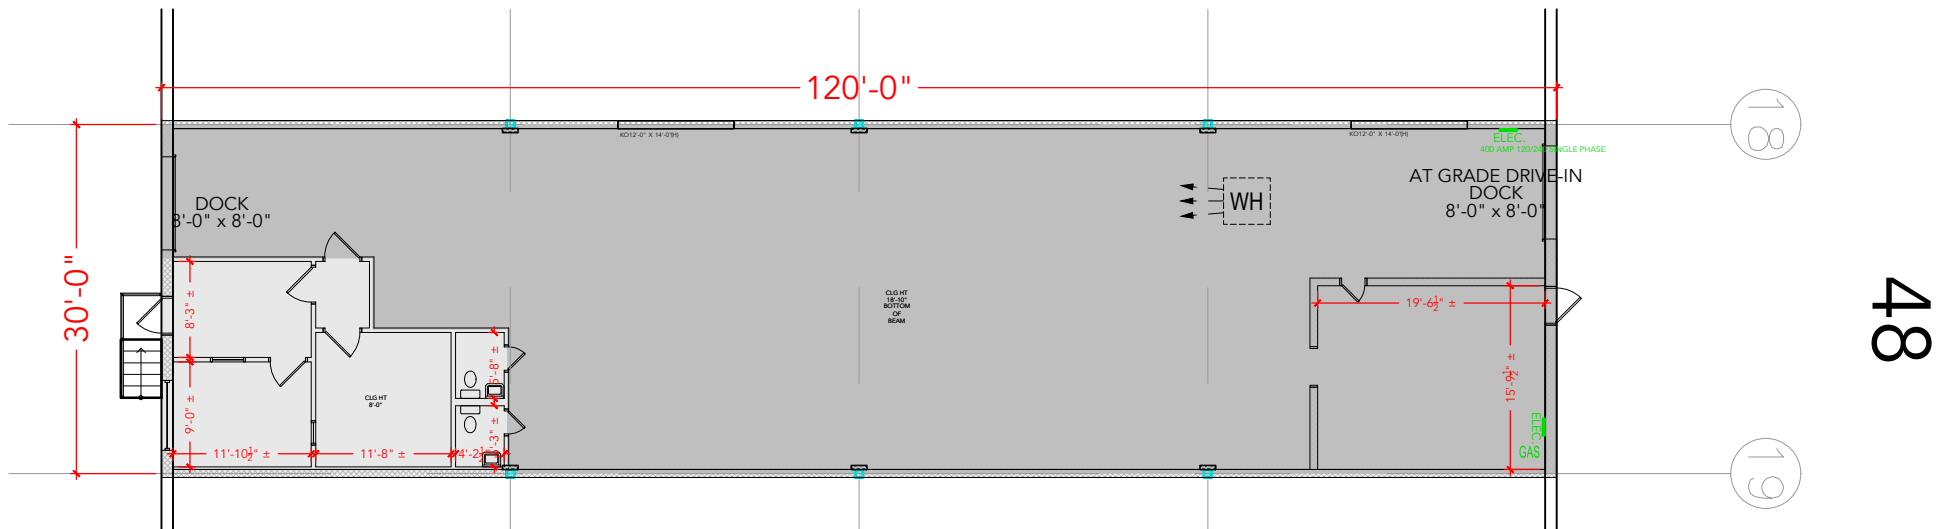

## Floor Plan