



TOTAL SF AVAILABLE -1,392 RSF

* MECH ROOM CORE FACTOR INCLUDED

[Click to access 3D model](#)

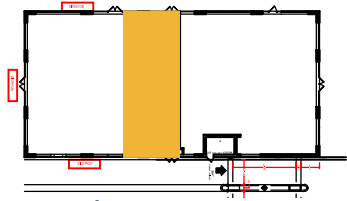

Key Plan

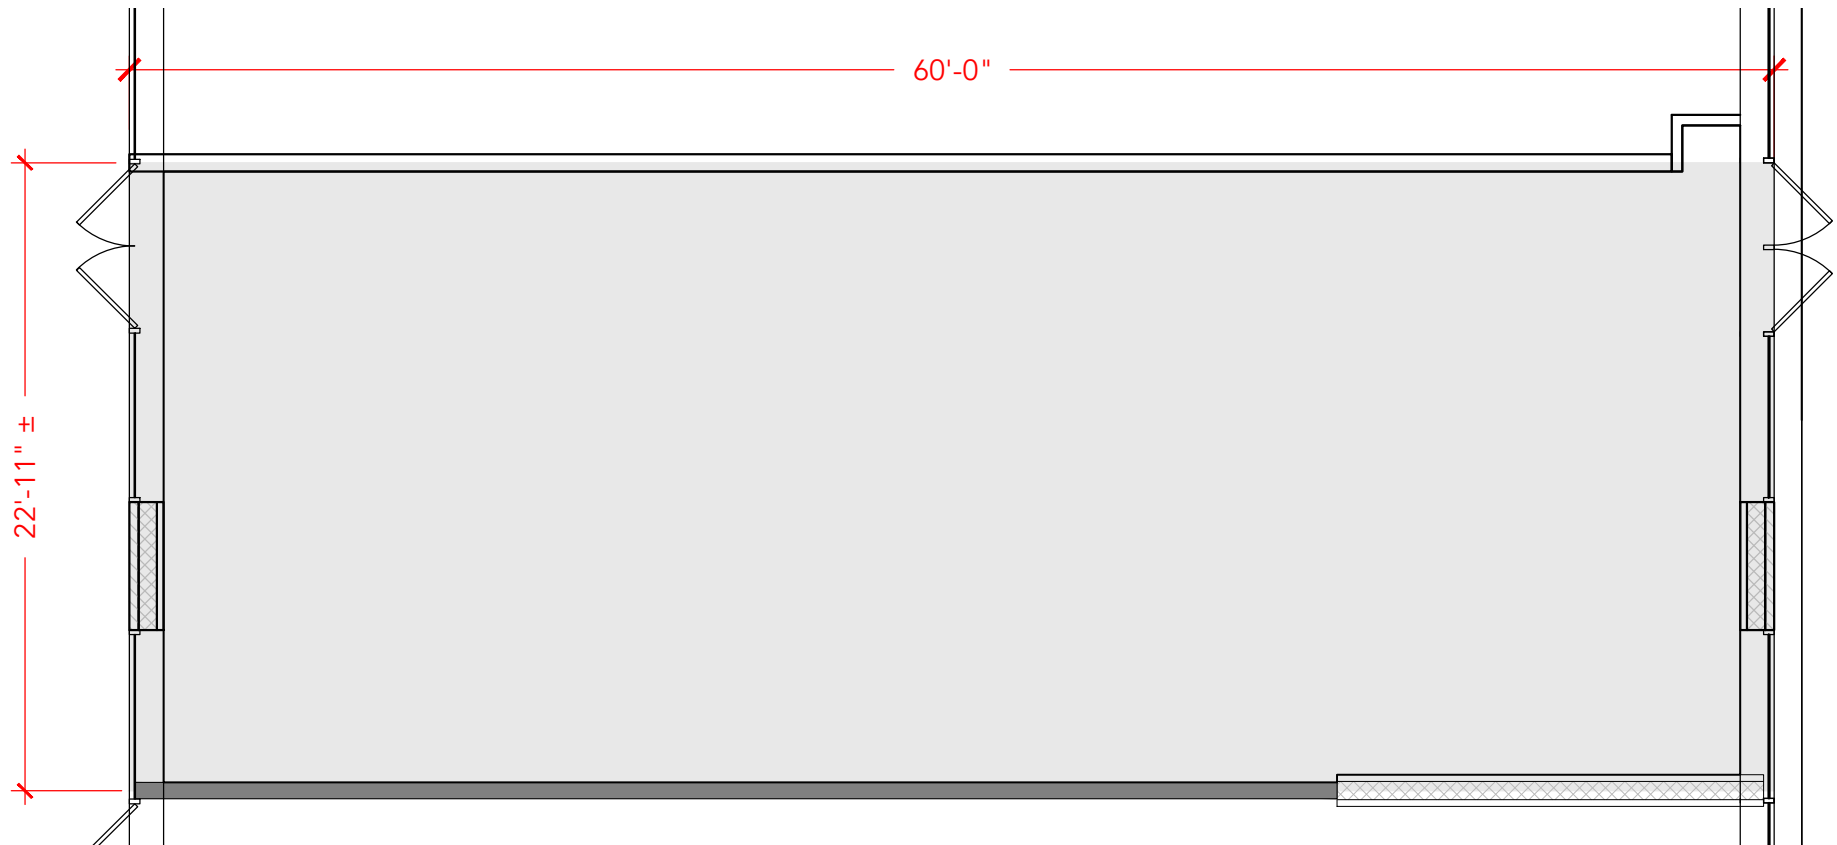

Floor Plan