



## COLUMBIA CORPORATE PARK IV

8825 STANFORD BLVD. COLUMBIA, MD 21045 SUITE 204-205

## TOTAL SF AVAILABLE - 4,473 RSF (16%)



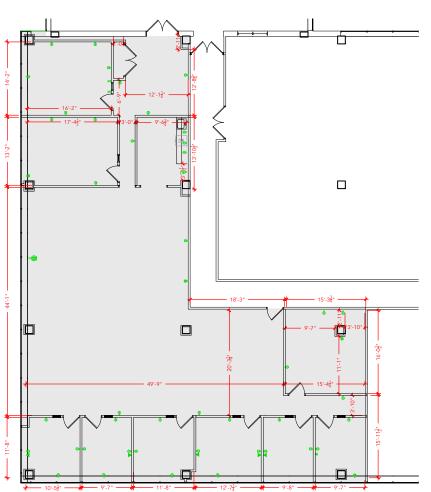

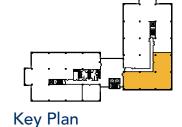

**Floor Plan**