


CCP 100

6011 UNIVERSITY BLVD ELLICOTT CITY, MD 21043
SUITE 220

TOTAL SF AVAILABLE -4,773 RSF (16%)

Key Plan

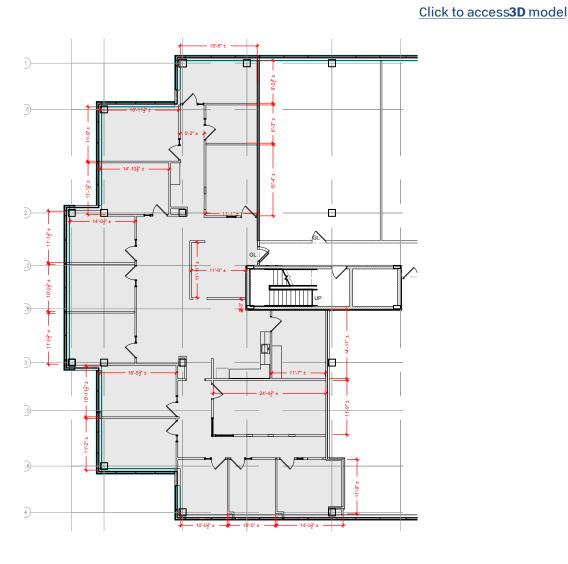

Floor Plan