


CCP 100


6011 UNIVERSITY BLVD ELLICOTT CITY, MD 21043 SUITE 400

TOTAL SF AVAILABLE -4,979 RSF (16%)

Click to access3D model

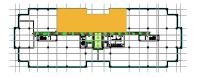

Key Plan

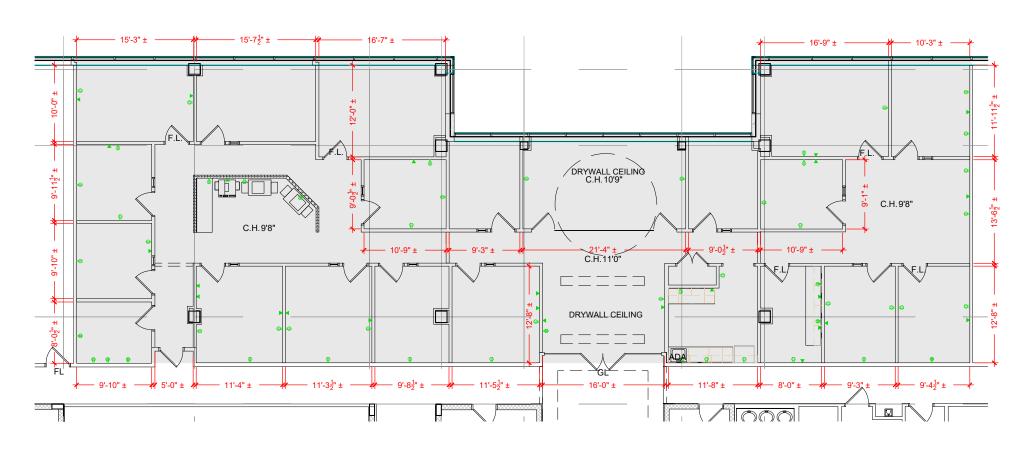

Floor Plan