


**TOTAL SF AVAILABLE 35,400 SF**

OFFICE - 5,660 SF


WAREHOUSE SF - 29,740 SF

2,390 SF. FREEZER ADDITION NOT INCLUDED IN TOTALS

[Click to access 3D model](#)

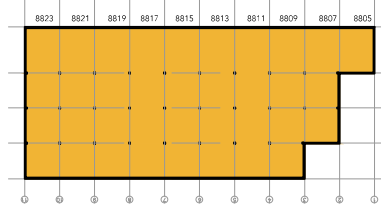

Key Plan

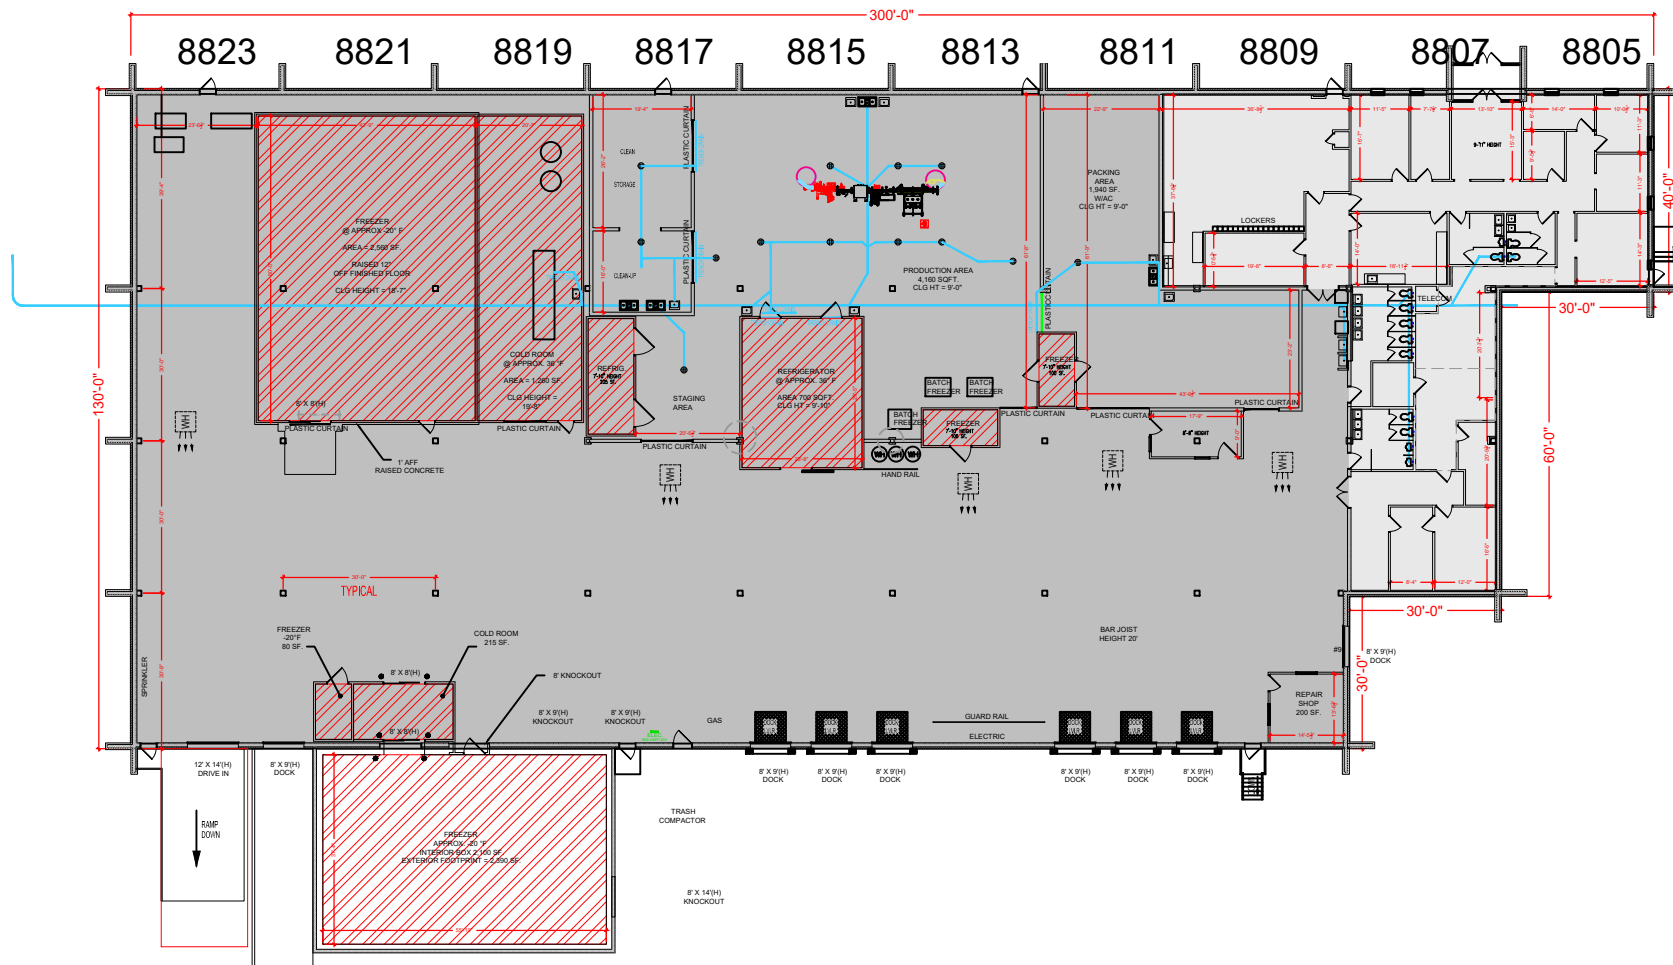

Floor Plan