


TOTAL SF AVAILABLE -24,006 RSF

OFFICE - 14,099 RSF


WAREHOUSE - 9,907 RSF

* % OF METER ROOM INCLUDED

[Click to access 3D model](#)

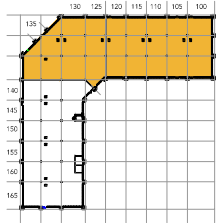

Key Plan

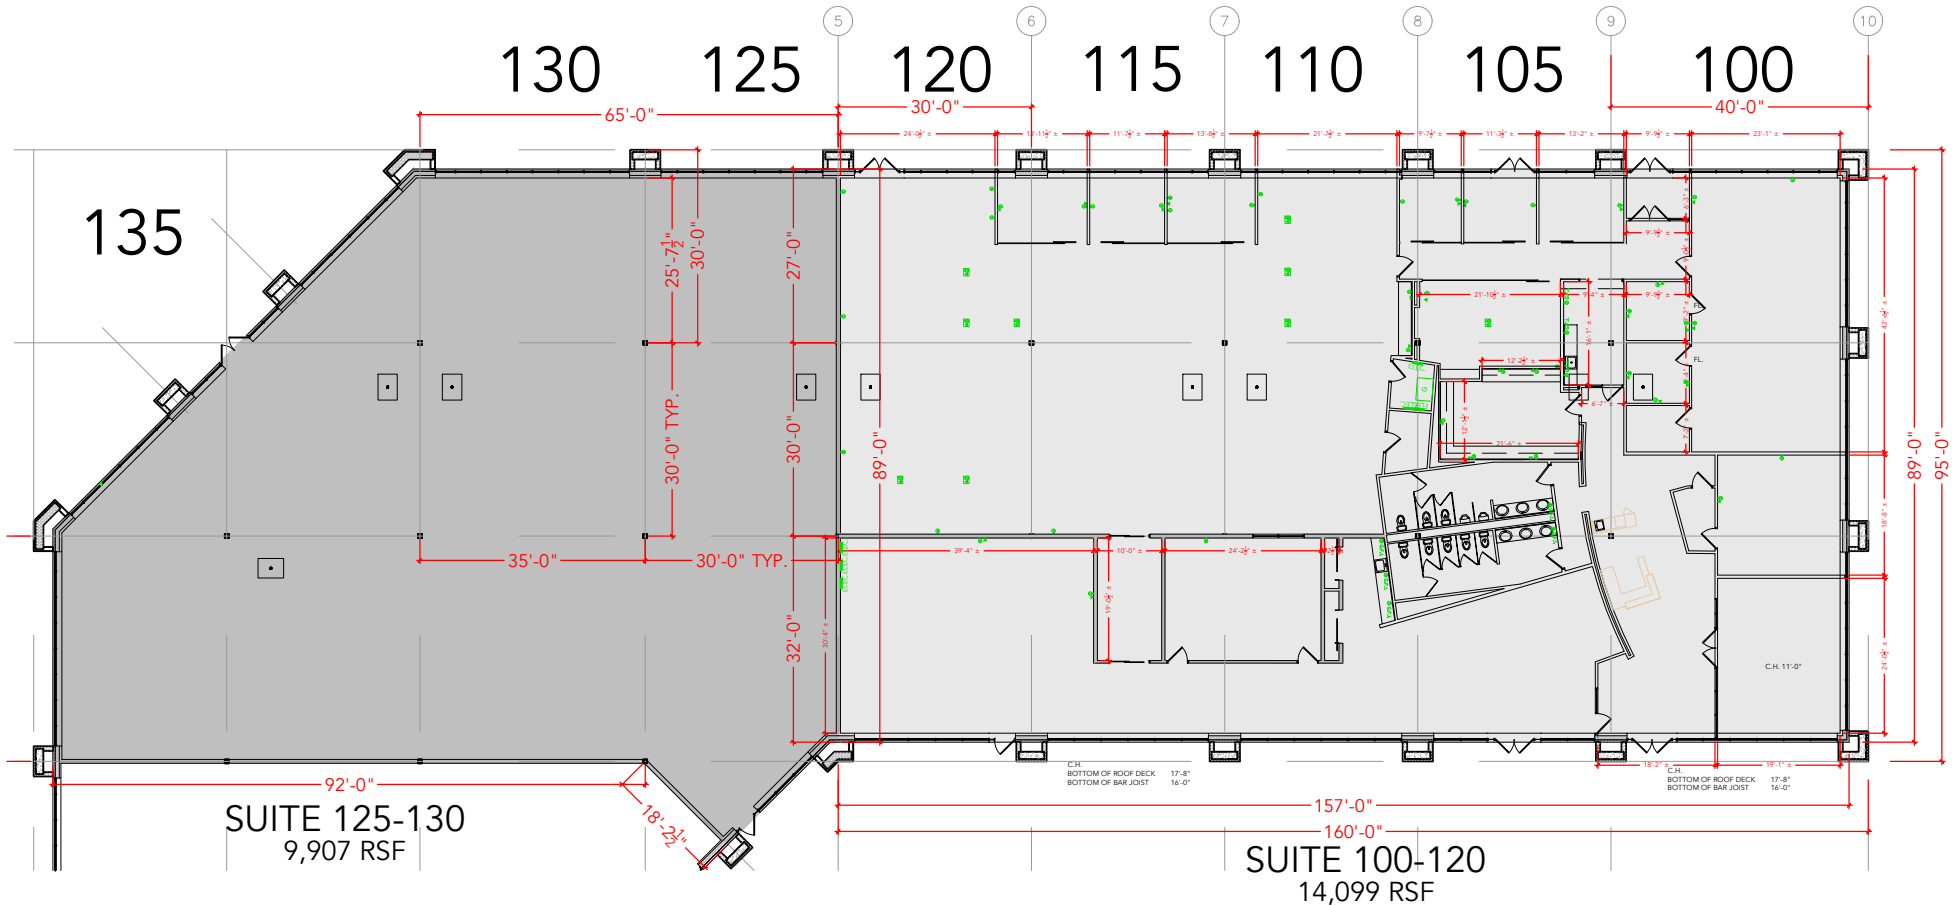

Floor Plan