


GUILFORD INDUSTRIAL PARK

9525 BERGER ROAD
SUITE N-P
COLUMBIA, MD 21046


Building Key Plan

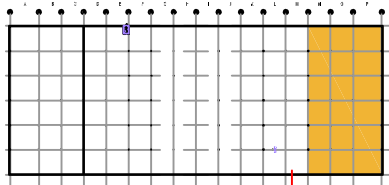

TOTAL SF AVAILABLE - 20,000 SF

OFFICE - 6,460 SF

WAREHOUSE SF - 13,540 SF

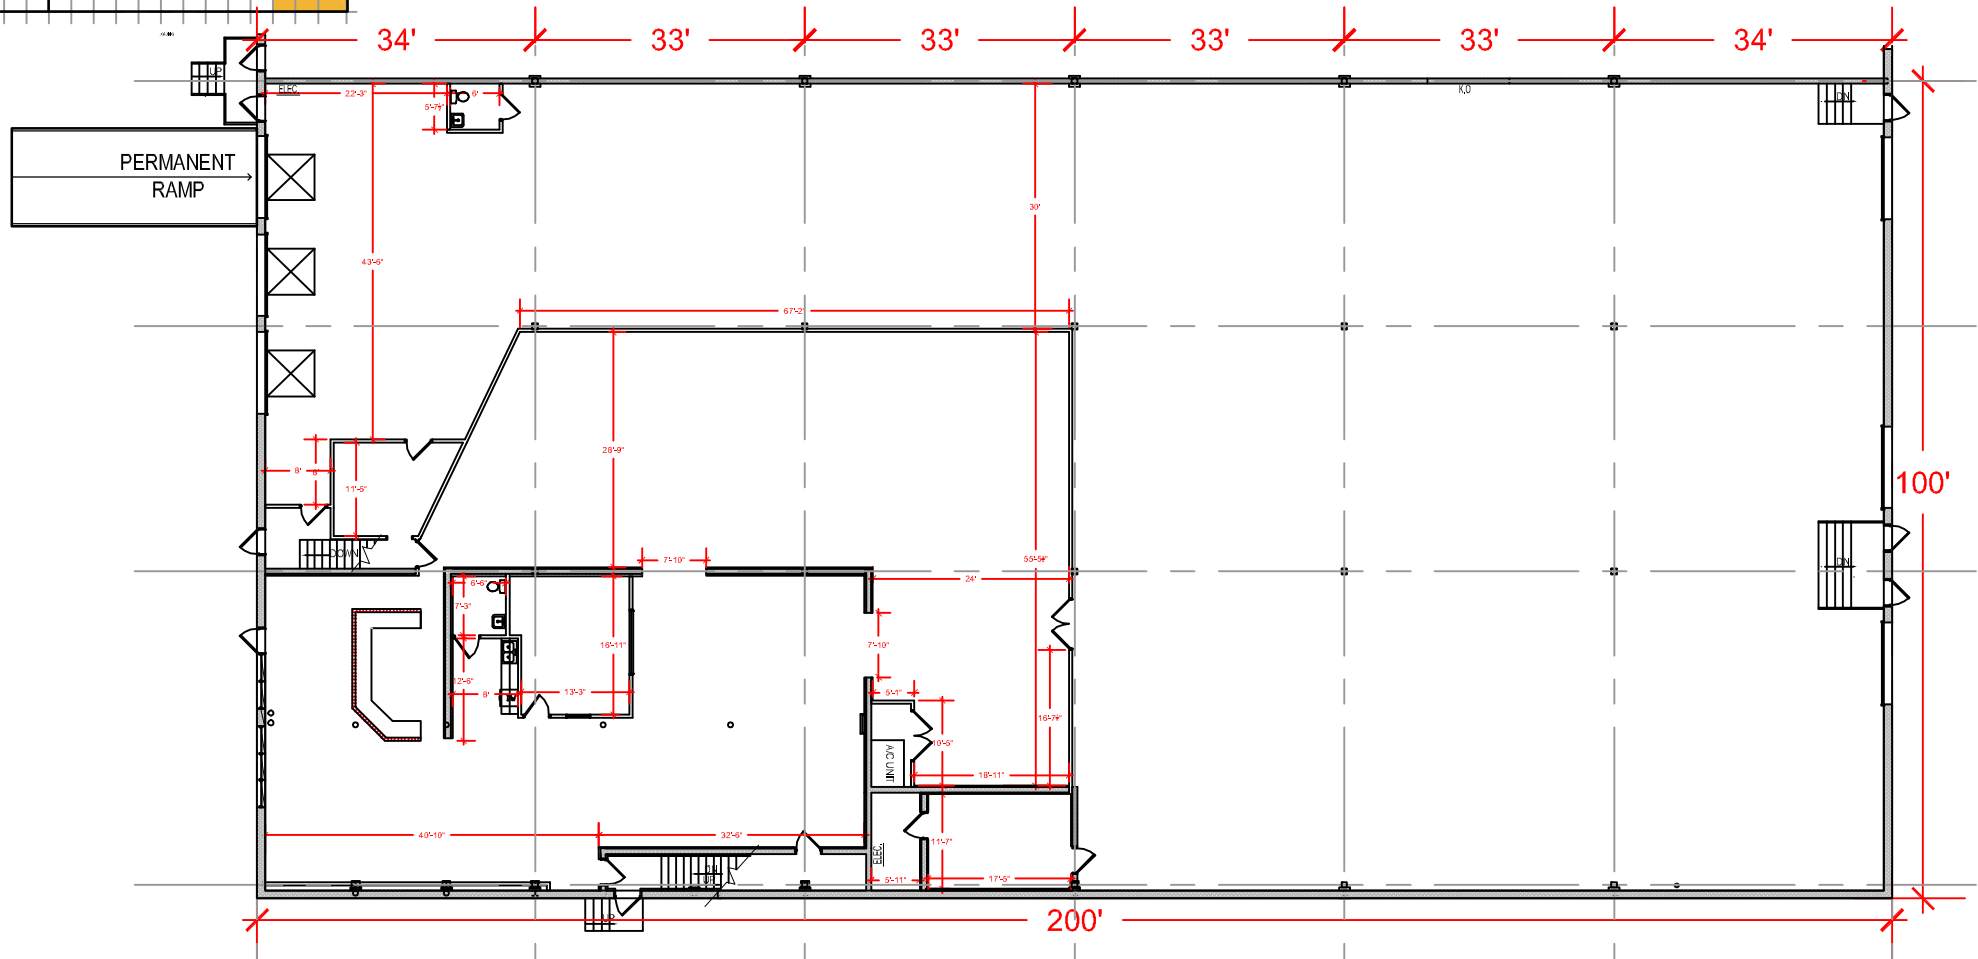

PLAN NOT TO SCALE - THIS IS NOT A CONSTRUCTION DOCUMENT

DRAWING #: GJ1-N-P ASBUILT DATE: 10.12.07