


# Lansdowne Industrial Park

178-194 Alco Place  
Baltimore, MD 21227

Total SF Available - 27,500 SF

Office - 1,200 SF  
Warehouse - 26,300 SF

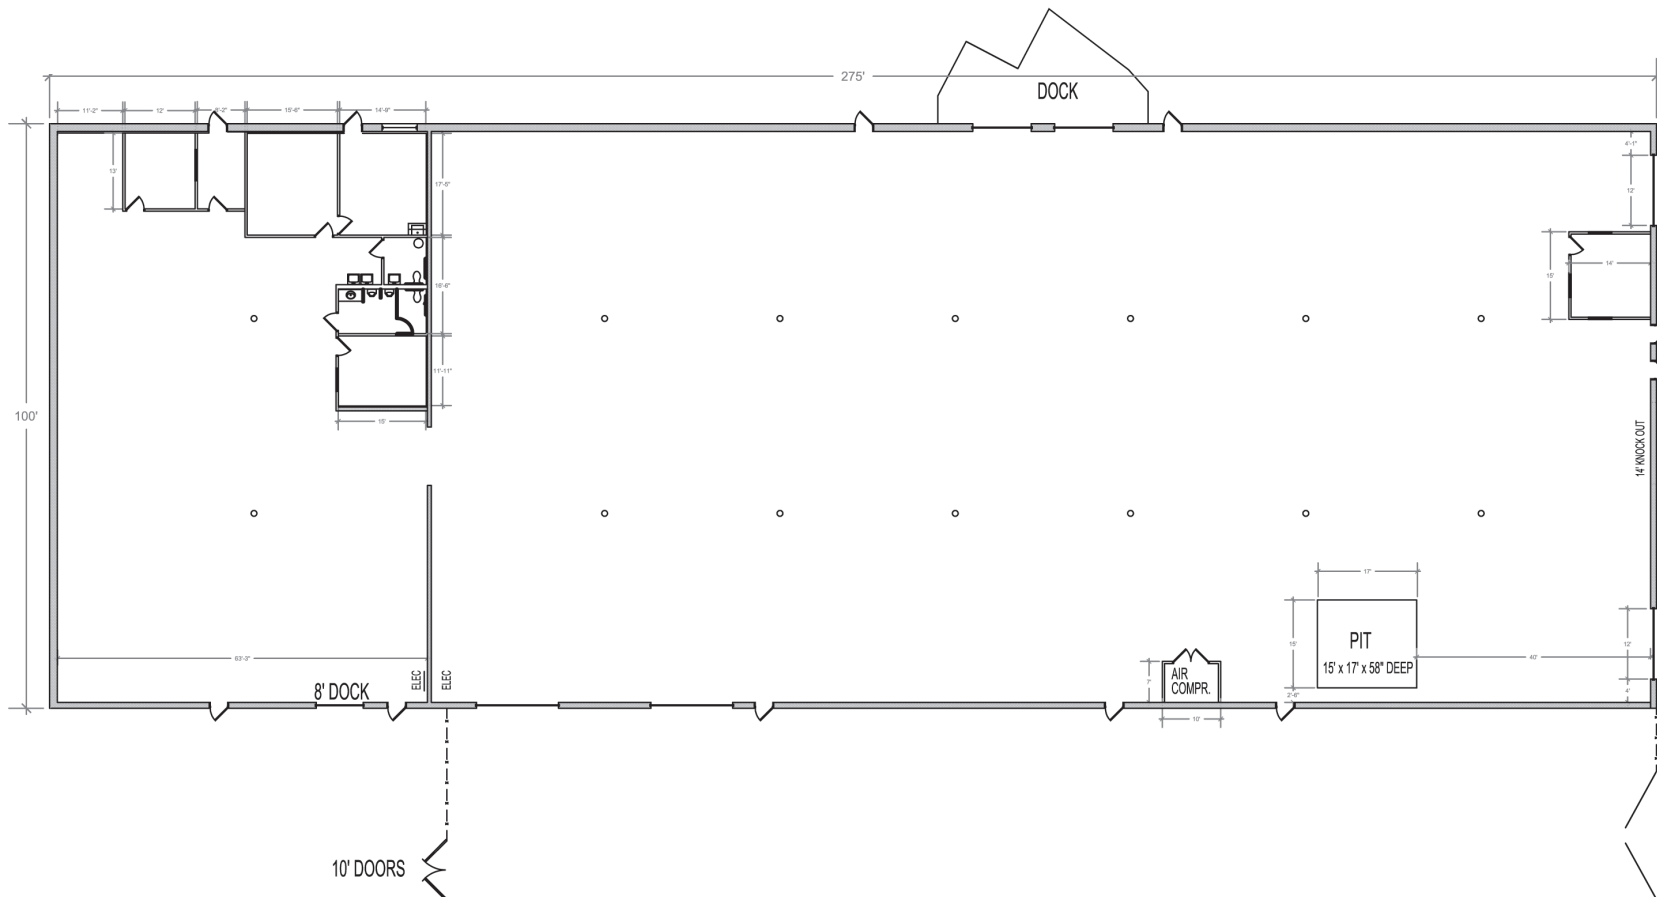

Plan not to scale - this is not a construction document.