




9 West Aylesbury Rd. , Suite F-G Baltimore, MD 21093

Office Flex Warehouse Distribution Design-Build Green-Build Retail

Nearly 15 million square feet throughout the Baltimore/Washington area

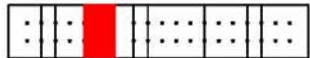


BUILDING KEY PLAN

AVAILABLE - 7,345 SF

2,451 SF - OFFICE
4,894 SF - WAREHOUSE
7,345 SF - TOTAL

Plan not to scale - this is not a construction document

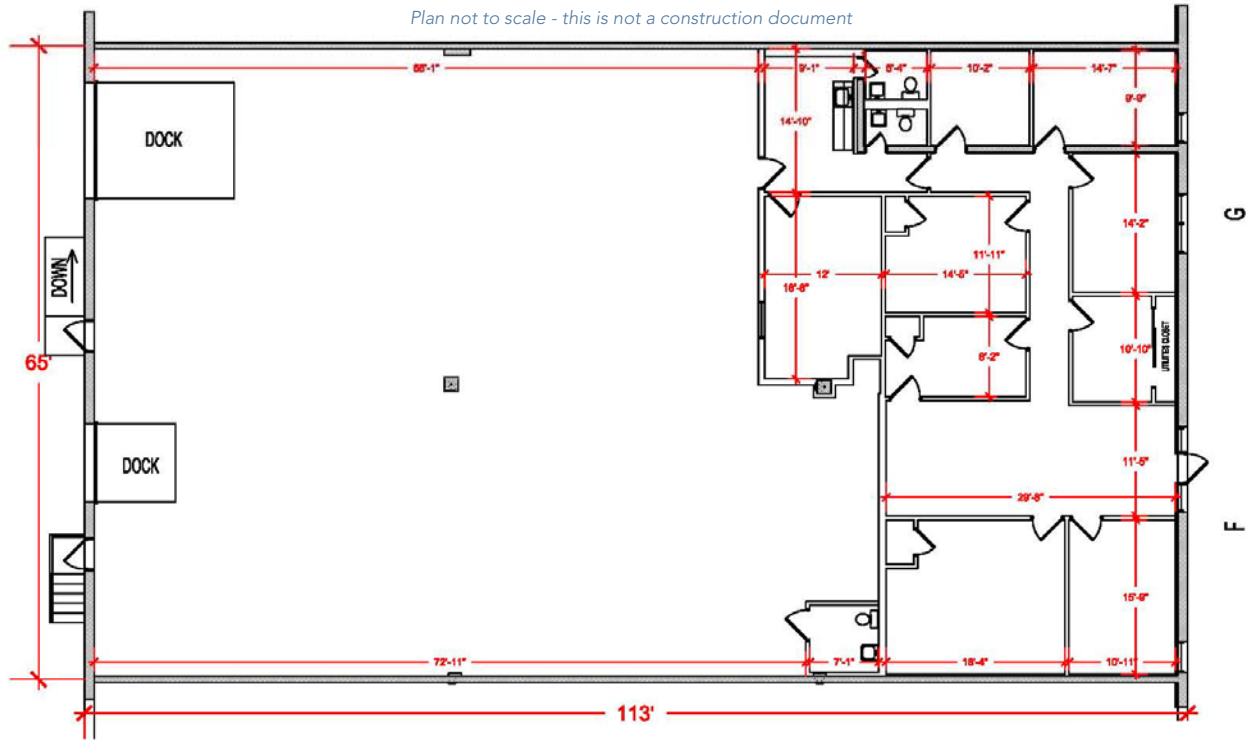

AYLESBURY ■ 9 WEST AYLESBURY RD. SUITE F-G ■ BALTIMORE ■ MD 21093