


Merchant Drive


2630-2638 Merchant Drive
Baltimore, MD 21230

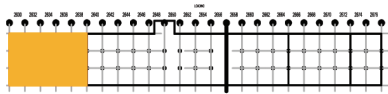

Building Key Plan

Total SF Available
15,000 SF

Office - 4,212 SF
Warehouse - 10,788 SF

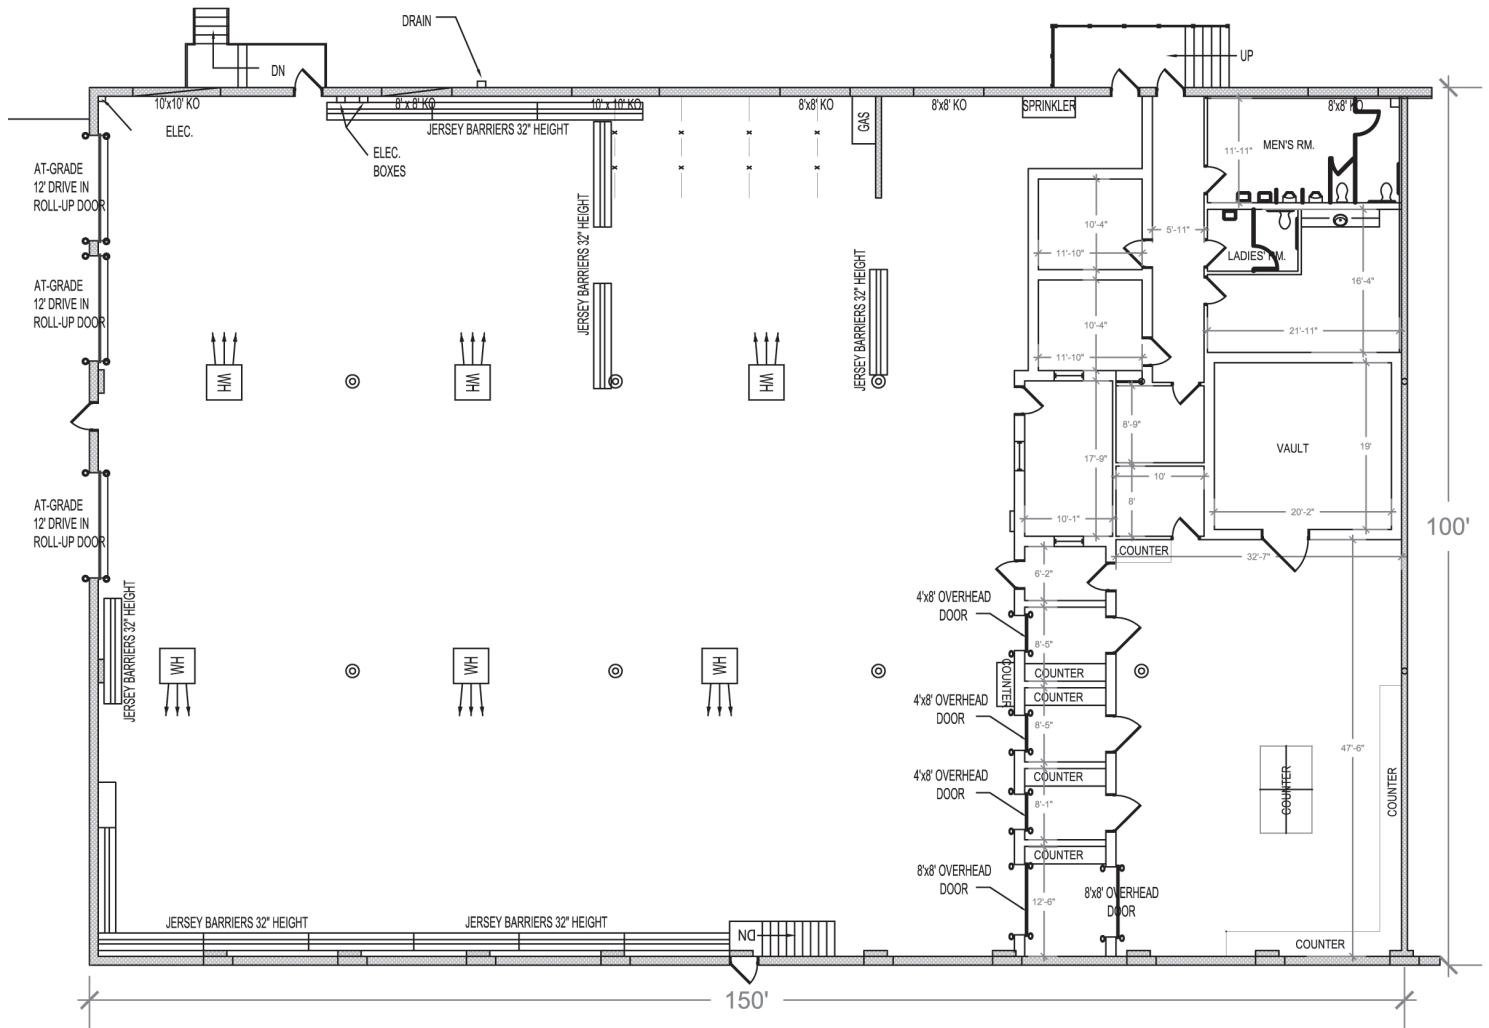

Plan not to scale - this is not a construction document.