



# Beltway Business Community 1

3761 Commerce Drive  
Suite 412  
Baltimore, MD 21227

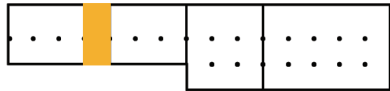

Total SF Office Available  
2,100 RSF

Building Key Plan

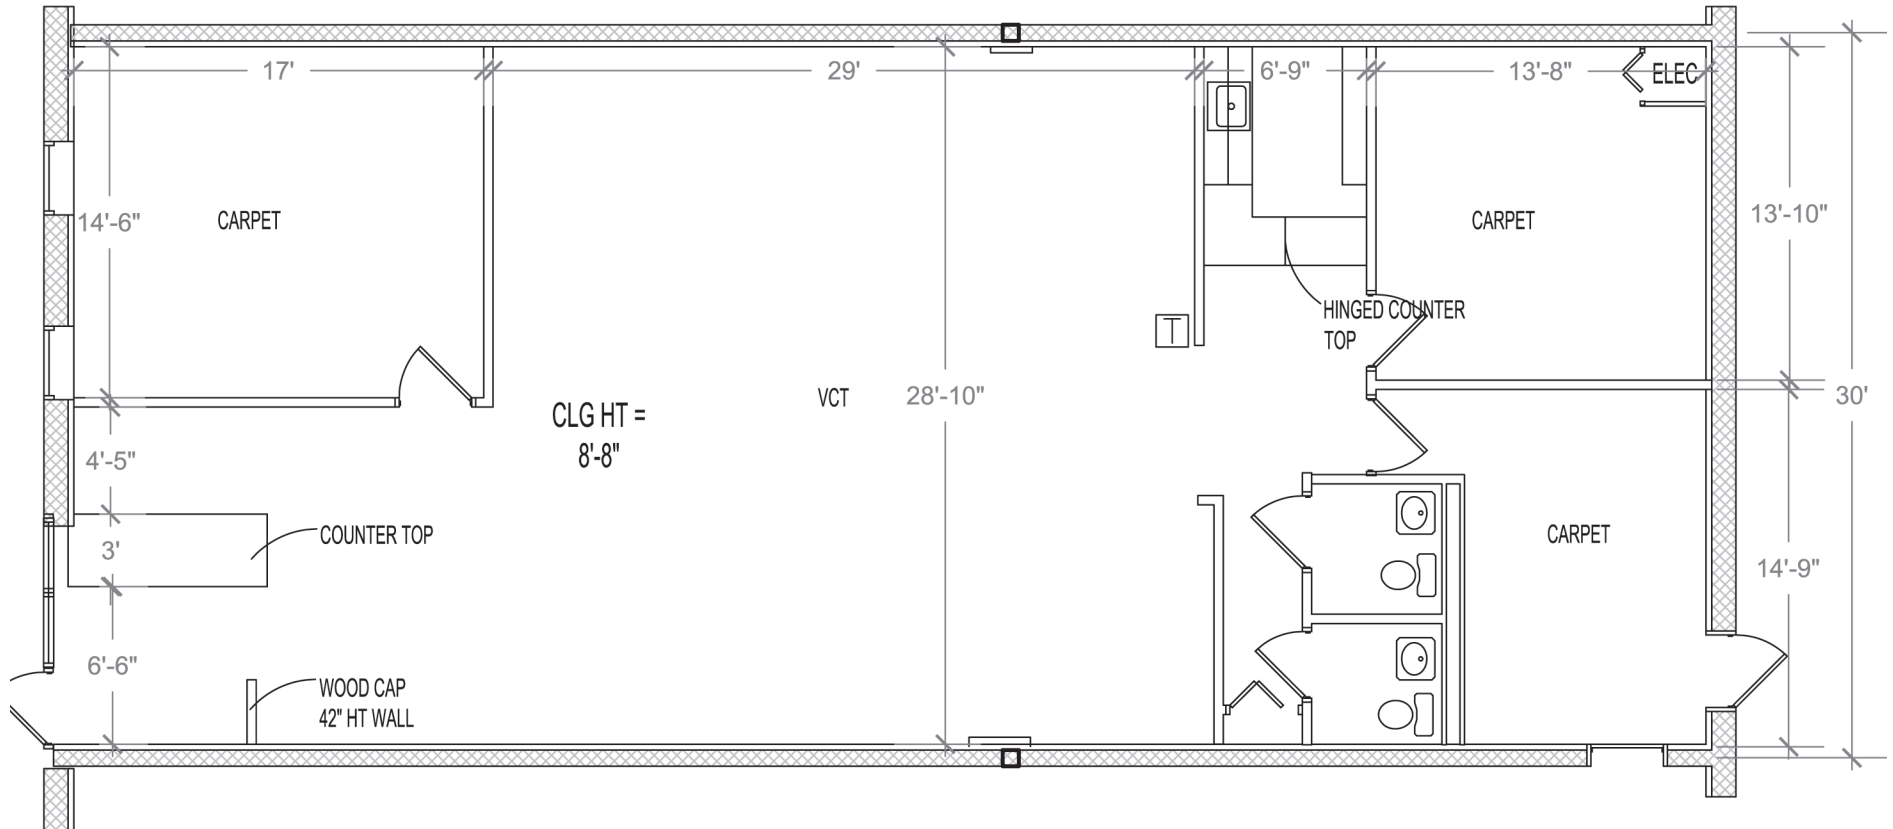

Plan not to scale - this is not a construction document.